


OFFICE OF THE
DOUGLAS COUNTY SURVEYOR

c-087 27S 6E 9
CINNAMON ECC

NAD 577678.26 4491281.57
83 43°14'25" 122° 6'50"

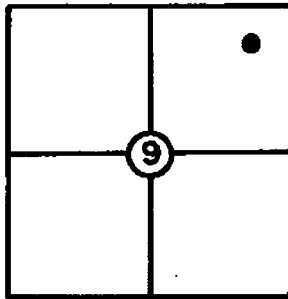

Unsurveyed
T 27 S, R 6E, Sec. 9

Station: Cinnamon Ecc.

Set By (Agency): DCSO

Date: 1974

VERTICAL CONTROL NGVD 29 CORPCON 6 NAVD88
6282.2 FT

Elevation: 6277.8 NGS(USC&GS) Line # _____ USGS Line # _____

Order
Of Precision V.A. Agency: DCSO Proj. #: 2004-8 Date: 1975

HORIZONTAL CONTROL OCS 27


Oregon State Plane Coordinates: Y(Northing) 577,715.73 X(Easting) 1,570,319.61
(South Zone)

Order
Of Precision 1/50,000 Agency: DCSO Proj. #: 2004-8 Date: 1975

Approximate Geographic Position: Latitude= _____ Longitude= _____

DESCRIPTION: To reach Cinnamon Ecc. from
Cinnamon, 60 S.W. downhill along the ridge
approx. 1/4 mi. to sta. which is a Douglas
County Brass cap stamped "Cinnamon Eccentric
1974" set in concrete platform flush w/the
ground.

SKETCH

 

VICINITY: Diamond Lake area.

NOTE: For Possible Further Information On This Station, Please Contact The Douglas
County Surveyors Office, Rm. 205 Douglas County Justice Bldg., Roseburg, OR.
97470 Phone 672-3311 Ext. 272. Douglas County residents outside the
Roseburg calling area dial toll free 1-800-452-0991.