

OFFICE OF THE  
DOUGLAS COUNTY SURVEYOR

Station: Clell Azimuth T 28 S, R 5 1/2 E, Sec 29 UNS

Set By (Agency): DCSO

Date Set: 1974

Recovered By FLI (DCSO)



Date Recovered 7-25-84

Recovered By OSHD 9/10/90

Date Recovered FD. OK

Recovered By \_\_\_\_\_

Date Recovered \_\_\_\_\_

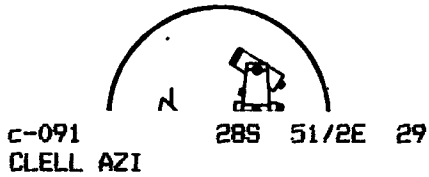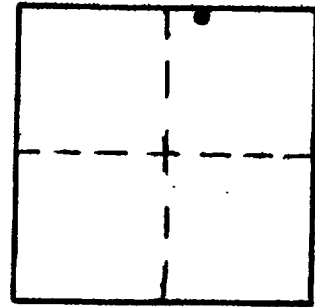

NAD 535400.87 4481713.67  
83 43° 7'26" 122° 8'48"

VERTICAL CONTROL NGVD 29 CORPCOM 6 NAVD 88 5233.004 FT

Elevation: 5228.653 NGS Line # \_\_\_\_\_ USGS Line # \_\_\_\_\_ OSHD Line # \_\_\_\_\_

Precision: 2nd Agency: DCSO Proj. # 2004-8 CS57/23 Date: 1974

HORIZONTAL CONTROL DCS 27

South Zone State Plane Coordinates: Y(Northing) 535,438.97 X(Easting) 1,560,752.31

Precision: 1/25,000 Agency: DCSO Proj. # 2004-8 CS57/23 Date: 1975

Approximate Geographic Position: Latitude 43°07'27" Longitude 122°08'44"

DESCRIPTION and TO REACH

SKETCH

0.7 mi. SW along new Hwy. 230  
from junction of new Hwy. 138  
and new Hwy. 230.

Brass cap in 6" belltile, 60 ft.  
northwest of edge of pavement.

**Reference Marks:**

Note: For further information, contact the Douglas County Surveyor's Office, Room 205 Douglas County Justice Building, Roseburg, OR 97470. Phone 440-4278. Douglas County residents outside the Roseburg calling area, dial toll free 1-800-452-0991.