



OFFICE OF THE
DOUGLAS COUNTY SURVEYOR

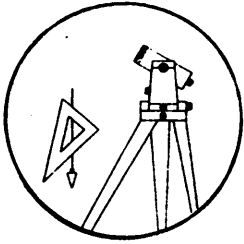

C-128

Station: C 502 T 31 S, R 2E, Sec 5
Set By (Agency): USC & GS
Date Set: 1949
Recovered By DCSO
Date Recovered 8-27-86
Recovered By _____
Date Recovered _____
Recovered By _____
Date Recovered _____

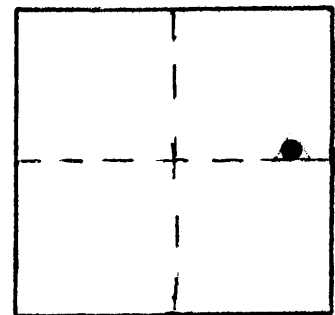

VERTICAL CONTROL NGVD 29

Elevation: 5509.126 NGS Line # 130 USGS Line # _____ OSHD Line # _____
Precision: 2nd Agency: USC&GS Proj. # 2013 Date: 1957

HORIZONTAL CONTROL

South Zone State Plane Coordinates: Y(Northing) _____ X(Easting) _____
Precision: _____ Agency: _____ Proj. # _____ Date: _____
Approximate Geographic Position: Latitude _____ Longitude _____

DESCRIPTION and TO REACH

SKETCH

2.15 mile southwesterly along old road on top of divide from intersection of roads 68, 30, and 800 in T30S,R2E,Sec.33. Monument is 25 feet southeast of road and 5 feet above road.

Brass Cap in round concrete monument flush with ground, with witness post.

Reference Marks:

Note: For further information, contact the Douglas County Surveyor's Office, Room 205 Douglas County Justice Building, Roseburg, OR 97470. Phone 440-4278. Douglas County residents outside the Roseburg calling area, dial toll free 1-800-452-0991.