


OFFICE OF THE
DOUGLAS COUNTY SURVEYOR


C-159

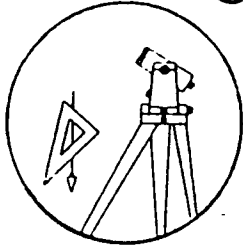

Station: CARRIKO
Date Set: 1998
Set By (Agency): DCSO
Date Recovered: 7-14-98
Recovered By: RWS SJF

T 27 S, R 5W, Sec 21

- Found New
 Reset Not Found
 Referenced Destroyed

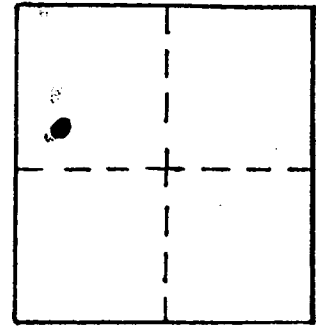

VERTICAL CONTROL

Elevation: 484.39 NGS Line # _____ USGS Line # _____ OSHD Line # _____
Precision: 3rd Agency: DCSO Proj. # 200⁶⁶¹⁵⁷7 Date: 1998

HORIZONTAL CONTROL CORPSCON6 NAVD88 487.91 FT.

South Zone O.C.S. 27: Y(Northing) _____ X(Easting) _____

South Zone O.C.S. 83: Y(Northing) 575438 X(Easting) 4174323

Precision: GIS SCALED Agency: DCSO Proj. # _____ Date: 2014

Approx. NAD 83 Geographic Position: Latitude 43 12 41 Longitude 123 18 05

DESCRIPTION and TO REACH

A 3 INCH DIAMETER DCSO DRILL CAP STAMPED "CARRIKO 1998"
SET FLUSH IN TOP OF CONCRETE BRIDGE ABUTMENT.

MONUMENT LIES JUST SOUTH (SEE SKETCH) FROM INTERSECTION
OF DOUGLAS AVENUE (CO. RD. #4A) AND DAWSON ROAD (CO. RD. 148)
IN T27S, R5W, SEC 21.

Reference Marks:

