

11/18/81


OFFICE OF THE

d-012  
D 666

24S 5W 8

DOUGLAS COUNTY SURVEYOR

NAD 681572.92 4173141.79  
83 43°30' 8" 123°19'13"

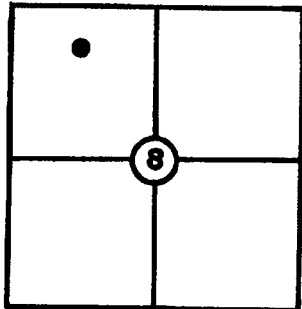

T 24 S, R 5W, Sec. 8

Station: D 666

Set By (Agency): OSHD

Date: 1975

D-012

CORPSCONG NAVD88  
571.44 FT

NGVD 29 561.88 VERTICAL CONTROL

Elevation: 561.88 NGS(USC&GS) Line # \_\_\_\_\_ OSHD  
USGS Line # 369

Order Of Precision 3rd Agency: OSHD Proj. #: \_\_\_\_\_ Date: 1977

HORIZONTAL CONTROL

OCS 27

Oregon State Plane Coordinates: Y(Northing) 681,607.28 X(Easting) 1,252,182.03  
(South Zone)

Order Of Precision 1/25,000 Agency: DCSO Proj. #: 2010-4 Date: 1978

Approximate Geographic Position: Latitude= 43° 30' <sup>09</sup>08" C.S. 59/47 Longitude= 123° 19' <sup>09</sup>22"

DESCRIPTION: A standard OSHD BM Brass

← Abridged version  
keyed into SARS.

disk stamped "D 666 1975" and set in a concrete

headwall at the SE cor. of a conc. box

culvert (Marsh Crk) passing beneath I-5 and

a dead-end Frontage Rd. on the E. side

of the freeway, approx. 20 ft.E. of the

centerline of a Frontage Rd. along the E.


side of I-5.

TO REACH: From Exit #146 on I-5, proceed 0.7  
mile Str'hly along Frontage Rd. on East side

of I-5 to Marsh Cr. and the station.  
VICINITY: Approx. 0.7 mi. S. of Rice Valley

exit. Along I-5 freeway.

SKETCH

 

NOTE: For Possible Further Information On This Station, Please Contact The Douglas  
County Surveyors Office, Rm. 205 Douglas County Justice Bldg., Roseburg, OR.  
97470 Phone 672-3311 Ext. 272.. Douglas County residents outside the  
Roseburg calling area dial toll free 1-800-452-0991.