

OFFICE OF THE
DOUGLAS COUNTY SURVEYOR

Station: D 739 RESET

T 21 S, R 5W, Sec 36


Date Set: 1990

Set By (Agency): NGS


Date Recovered: 8/30/94

Recovered By: RWS, SJF

- Found New
 Reset Not Found
 Referenced Destroyed

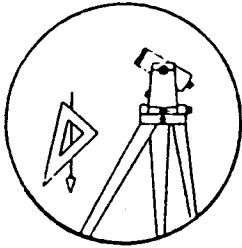

D-084

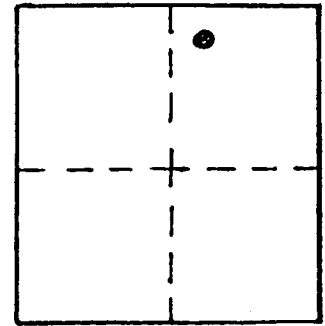

VERTICAL CONTROL

111.514 METERS

Elevation: NAVD 88 = 365.860 FT NGS Line # L25035 USGS Line # _____ OSHD Line # _____

Precision: 1ST ORD. CLASS 2 Agency: NGS Proj. # _____ Date: 1990

HORIZONTAL CONTROL

South Zone O.C.S. 27: Y(Northing) _____ X(Easting) 754813

South Zone O.C.S. 83: Y(Northing) _____ X(Easting) 4197817

Precision: GIS SCALED Agency: DCSO Proj. # _____ Date: 2014

Approx. NAD 83 Geographic Position: Latitude 43° 42' 28" Longitude 123° 13' 48"

DESCRIPTION and TO REACH

A 3 1/2 INCH DIAMETER NGS DISK STAMPED "D 739 RESET 1990" SET IN TOP OF 12 INCH DIAMETER CONCRETE POST WHICH IS FIRMLY SET AND PROTRUSIVE 1 INCH ABOVE GROUND.

FROM THE INTERSECTION OF TERRITORIAL HWY. (Co. Rd #116) AND STATE HIGHWAY 38 IN T21S, R5W, SECTION 23 PROCEED WESTERLY ALONG STATE HIGHWAY 38 APPROXIMATELY 0.3 MILES TO PRIVATE ACCESS FRONTAGE ROAD (A SEGMENT OF OLD ABANDONED HIGHWAY) AND MONUMENT ON LEFT.

Reference Marks:

