


2/03 A.L

OFFICE OF THE
DOUGLAS COUNTY SURVEYOR

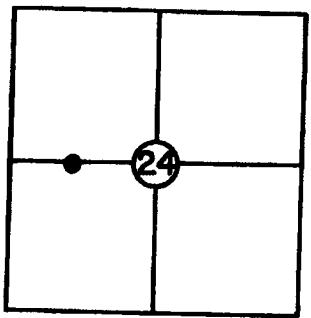

T 27 S, R 5 W., Sec. 24
Station: DIXIE AZI RM 1
Set By (Agency): DCSO
Date: 1980
FDOK DCSO 2/03

D-102

VERTICAL CONTROL

NGVD 29 Elevation: 559.99 NGS(USC&GS) Line # _____ USGS Line # _____
CORPSCONIG NAVD 88 563.49 FT

Order Of Precision 3rd Agency: DCSO Proj. #: 2007 Date: 2003
C566/63

HORIZONTAL CONTROL


Order Of Precision 1/25,000 Agency: DCSO Proj. #: 2004-19 Date: 1980
Approximate Geographic Position: Latitude= 43° 12' 25" Longitude= 123° 14' 40"

Order Of Precision 1/25,000 Agency: DCSO Proj. #: 2004-19 Date: 1980

Approximate Geographic Position: Latitude= 43° 12' 25" Longitude= 123° 14' 40"

DESCRIPTION: A standard DCSO brass cap set
in a conc. filled 6"x36" belltile buried
0.5 ft. above ground, 39 ft. South of Buck-
horn Rd. centerline, 7.1 ft. N 89° E from
72 + 78.67 FT, 37.5 ft. Northerly of PP#
5A/1, 2.6 ft. North of sign post.

SKETCH

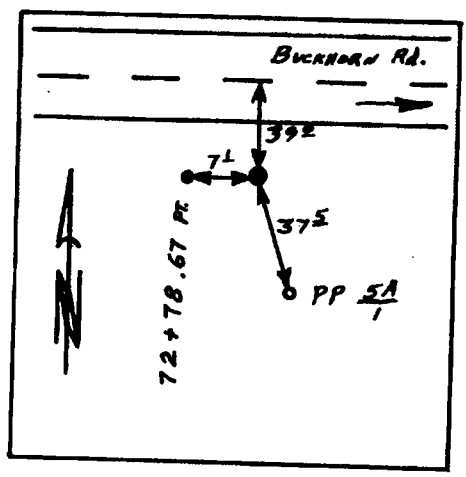

VICINITY: Approx. 0.2 mi. West Along Buck-
horn Rd. from the intersection of Buckhorn
Rd. and Dixonville Rd.

NOTE: For Possible Further Information On This Station, Please Contact The Douglas County Surveyors Office, Rm. 205 Douglas County Justice Bldg., Roseburg, OR. 97470 Phone 672-3311 Ext. 272. Douglas County residents outside the Roseburg calling area dial toll free 1-800-452-0991.