


OFFICE OF THE
DOUGLAS COUNTY SURVEYOR

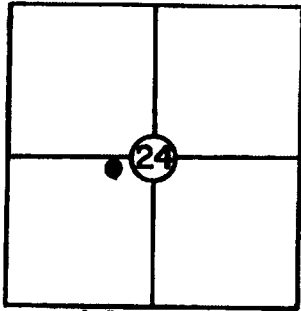

T 27 S, R 5 W., Sec. 24

Station: DIXIE RM 1

Set By (Agency): DCSO

Date: 1980

FD. OK 2/2003

D-105

VERTICAL CONTROL

CORPSCON 6 NAVD88 581.73 FT

NAV029

Elevation: 578²³ NGS(USC&GS) Line # _____ USGS Line # _____

Order Of Precision 3rd Agency: DCSO Proj. #: CS66/63 Date: 2003

HORIZONTAL CONTROL

DCS 27

Oregon State Plane Coordinates: Y(Northing) 573,381.97 X(Easting) 1,269,438.69
(South Zone)


Order Of Precision 1/25,000 Agency: DCSO Proj. #: 2004-19 Date: 1980

Approximate Geographic Position: Latitude= 43° 12' 26" Longitude= 123° 14' 27"

DESCRIPTION: A standard DCSO brass cap set (25.9) (26.8)

in a conc. filled 6"x36" belltile buried
flush with the ground. Stamped 'Dixie RM1
1980" 5.5 ft. South of a North R/W fence,
34 ft. North of Buckhorn Rd. centerline,
7.9 ft. S 57° E of PP# 2/1, 11.5 ft. S 67° E
from Sta. 82 + 50.00 POT

SKETCH

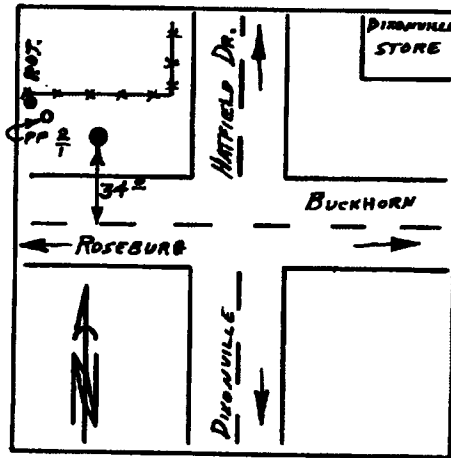

VICINITY: NW corner of the intersection of
Buckhorn Rd., Dixonville Rd., and Hatfield Dr.

NOTE: For Possible Further Information On This Station, Please Contact The Douglas County Surveyors Office, Rm. 205 Douglas County Justice Bldg., Roseburg, OR. 97470 Phone 672-3311 Ext. 272.. Douglas County residents outside the Roseburg calling area dial toll free 1-800-452-0991.