

OFFICE OF THE  
DOUGLAS COUNTY SURVEYOR

Station: F 502 T 31 S, R 2E, Sec 3

Set By (Agency): USC & GS

Date Set: 1949

Recovered By DCSO


Date Recovered 8-27-86

Recovered By \_\_\_\_\_


Date Recovered \_\_\_\_\_

Recovered By \_\_\_\_\_

Date Recovered \_\_\_\_\_

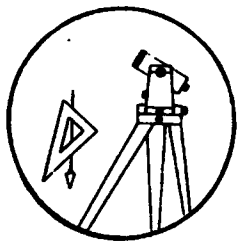

F-029

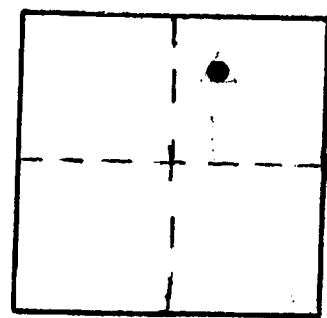

VERTICAL CONTROL NGVD 29 CORPS CON 6 NAVD 88 4588.602 FT

Elevation: 4584.974 NGS Line # 130 USGS Line # \_\_\_\_\_ OSHD Line # \_\_\_\_\_

Precision: 2nd Agency: USC&GS Proj. # 2013 Date: 1957

HORIZONTAL CONTROL

South Zone State Plane Coordinates: Y(Northing) \_\_\_\_\_ X(Easting) \_\_\_\_\_

Precision: \_\_\_\_\_ Agency: \_\_\_\_\_ Proj. # \_\_\_\_\_ Date: \_\_\_\_\_

Approximate Geographic Position: Latitude \_\_\_\_\_ Longitude \_\_\_\_\_

DESCRIPTION and TO REACH

SKETCH

From intersection of Forest Service road 68 with Highway 230, in T31S,R3E, Sec.29, go northwesterly along road 68 9.3 miles to road 750 on left. go left on road 750 0.4 to 0.5 miles, 35 feet left (southwest) of centerline.

Brass Cap in boulder, 1 feet above ground level, 4 feet above road.

Reference Marks:

Note: For further information, contact the Douglas County Surveyor's Office, Room 205 Douglas County Justice Building, Roseburg, OR 97470. Phone 440-4278. Douglas County residents outside the Roseburg calling area, dial toll free 1-800-452-0991.