


g-017
GAS 1972

26S 6W 25

OFFICE OF THE
DOUGLAS COUNTY SURVEYOR

NAD 603200.68 4160883.09
83 43°17'10" 123°21'23"

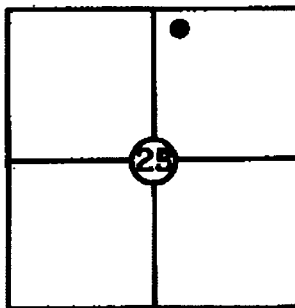

T 26 S, R 6W, Sec. 25

Station: Gas

Set By (Agency): DCSO

Date: 1972

NGVD 29

VERTICAL CONTROL CORPSCON 6 NAVD88 531.958 FT

Elevation: 528.471 NGS(USC&GS) Line # _____ USGS Line # _____

Order
Of Precision 2nd Agency: DCSO Proj. #: 2006 Date: 1974

HORIZONTAL CONTROL

OCS 27
Oregon State Plane Coordinates: Y(Northing) 603,235.65 X(Easting) 1,239,924.12
(South Zone)

Order
Of Precision 1/25,000 Agency: DCSO Proj. #: 2006 Date: 1974


Approximate Geographic Position: Latitude= _____ Longitude= _____

DESCRIPTION: From W. end of Bridge of Rd.

#115, go 60 ft. S. Bridge is over I-5 &
near Douglas County Lumber Co., Point
sees the freeway.

VICINITY: Winchester, N. side of River.

SKETCH

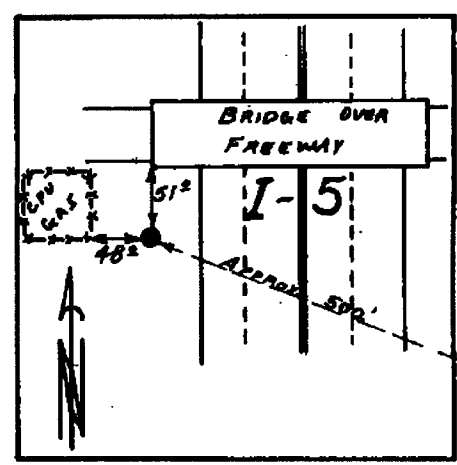

NOTE: For Possible Further Information On This Station, Please Contact The Douglas County Surveyors Office, Rm. 205 Douglas County Justice Bldg., Roseburg, OR. 97470 Phone 672-3311 Ext. 272. Douglas County residents outside the Roseburg calling area dial toll free 1-800-452-0991.