

OFFICE OF THE


DOUGLAS COUNTY SURVEYOR

1/19/81

g-041
GREEN BUTTE

26S 7W 8

NAD 621045.45 4109544.33
83 43°19'49" 123°33' 6"

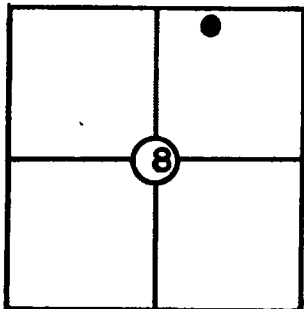

T 26 S, R 7 W, Sec. 8

Station: GREEN BUTTE

Set By (Agency): DCSO

Date: 1971

VERTICAL CONTROL CORPS CON 6 NAVD88 2451 FT

NGVD 29

Elevation: 2447 NGS(USC&GS) Line # _____ USGS Line # _____

Order _____ (Roseburg Primary)
Of Precision VA Agency: DCSO Proj. #: 2002 Date: 1971

HORIZONTAL CONTROL

OCS 27


Oregon State Plane Coordinates: Y(Northing) 621,080.49 X(Easting) 1,188,585.36
(South Zone)

Order _____ (Roseburg Primary)
Of Precision 1/100,000 Agency: DCSO Proj. #: 2002 Date: 1971

Approximate Geographic Position: Latitude= 43°19'49" Longitude= 123°33'01"

DESCRIPTION: From the intersection of Co. Rd. #13 and BLM Rd. #26-7-11, proceed along 26-7-11 approx. 2 mi. to gate. Proceed through gate along 26-7-11 0.4 mi. to intersection with BLM Rd. #26-7-9.1. Cont. along 26-7-11 (left fork) to another intersection with BLM Rd. #26-7-8. Cont. along 26-7-11 0.1 mi. to intersection with BLM Rd. # 25-8-36.0. Cont. along 26-7-11 to turnoff on right side of road in curve to right. Witness post set on West side of road approx. 7 ft. above road in grassy area. Station bears N78°W approx. 300 ft. † from witness post. Total dist. from intersection of Co. Rd. #13 and 26-7-11 is 4.1 mi.

SKETCH

 

4-81 NOTE: Thick brush prohibits seeing almost all directions, RM2 found okay. GEQ GREEN BUTTE RM 2 bears N 71° 58' 40" E 39.68 ft. (grid)

NOTE: For Possible Further Information On This Station, Please Contact The Douglas County Surveyors Office, Rm. 205 Douglas County Justice Bldg., Roseburg, OR. 97470 Phone 672-3311 Ext. 272.. Douglas County residents outside the Roseburg calling area dial toll free 1-800-452-0991.