


H-027 HEATHER 215 5W 33

OFFICE OF THE
DOUGLAS COUNTY SURVEYOR

NAD 751297.23 4163'66.76
88 48°41'39" 123°17'28"

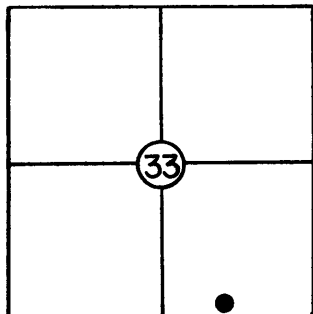

H-027

VERTICAL CONTROL

T 21 S, R 5W, Sec. 33

Station: HEATHER 1979

Set By (Agency): DCSO

Date: 1979

Elevation: _____ NGS(USC&GS) Line # _____ USGS Line # _____

Order
Of Precision _____ Agency: _____ Proj. #: _____ Date: _____

HORIZONTAL CONTROL

^{NAD 27}
Oregon State Plane Coordinates: Y(Northing) 751,272.04 X(Easting) 1,262,226.01
(South Zone)

Order
Of Precision 1/25,000 Agency: DCSO Proj. #: 2008 Date: 1979
(North County)


Approximate Geographic Position: Latitude= 43° 41' 40" Longitude= 123° 17' 24"

DESCRIPTION: A standard DCSO brass cap set in
conc. filled bell tile 6"x39" buried flush with
ground. 21.5 ft., S 60° E, to E.O.P. Hwy. 99,
1 ft. lower than road, 4 ft. from toe of cutbank.
Ctr. of steel culvert with conc. collar S 28½° W,

81.5 ft; witness post bears NW 4 ft.
A DCSO disk, stamped "HEATHER RM 1 1979" set flush
with ground bears S 54° 36' 38" E 85.30' (grid)
A DCSO disk, stamped "HEATHER RM 2 1979" set in
NE corner of 5 1/2' x 9 1/2' collar on culvert
bears S 27° 04' 19" W 80.36' (grid)

VICINITY: .6 miles northerly along Hwy. 99 from
Smith River Rd. intersection.

SKETCH

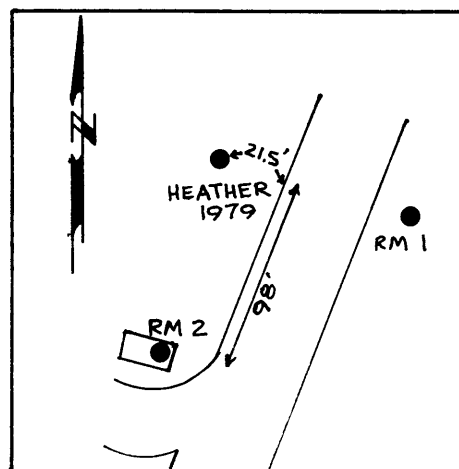

NOTE: For Possible Further Information On This Station, Please Contact The Douglas County Surveyors Office, Rm. 205 Douglas County Justice Bldg., Roseburg, OR. 97470 Phone 672-3311 Ext. 272.. Douglas County residents outside the Roseburg calling area dial toll free 1-800-452-0991.