OFFICE OF THE

DOUGLAS COUNTY SURVEYOR

H-061

Station: HAWKEYE T 27 S, R 7 W , Sec 24

Set By (Agency): DCSO

Date Set: 1989

Recovered By RWS,SJF

Date Recovered 5/19/89

Recovered By

Date Recovered

Recovered By

Date Recovered

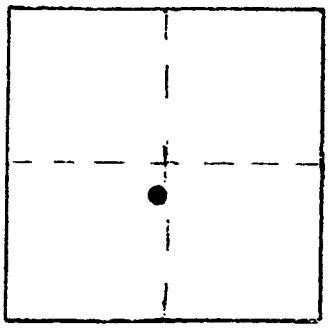

VERTICAL CONTROL

Elevation: 606.062 NGS Line # USGS Line # OSHD Line #

Precision: 2nd Agency: DCSO Proj. # 2007 Date: 1990

HORIZONTAL CONTROL CORPSCONG NAVD88 609.55 FT.

South Zone State Plane Coordinates: Y(Northing) 574283 X(Easting) 4127572

Precision: GIS SCALED Agency: DCS Proj. # Date: 2014

Approximate Geographic Position: Latitude Longitude

DESCRIPTION and TO REACH

A DCSO drill cap stamped "HAWKEYE 1989" set flush in rock cutbank approx. 3 ft. higher than road.

From the intersection of Lookingglass Transfer Rd. (Co.Rd.#317) and Colonial Rd. (Co.Rd.#32) proceed northeasterly along Colonial Rd. approx. 0.6 miles to monument on right.

SKETCH

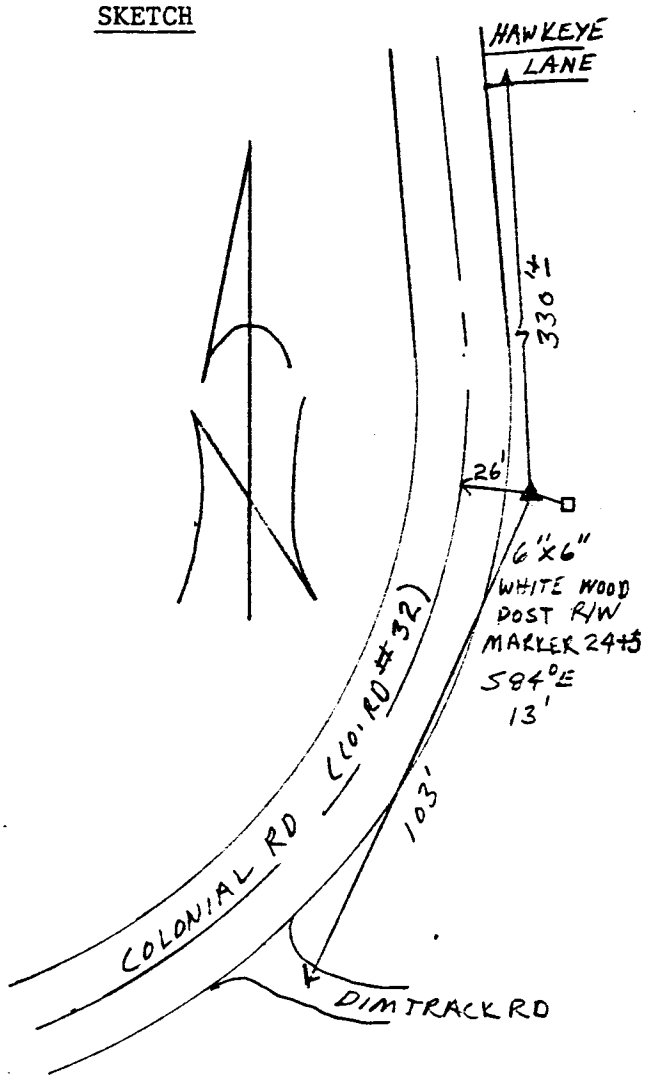

Reference Marks:

Note: For further information, contact the Douglas County Surveyor's Office, Room 205 Douglas County Justice Building, Roseburg, OR 97470. Phone 440-4278. Douglas County residents outside the Roseburg calling area, dial toll free 1-800-452-0991.