

OFFICE OF THE
DOUGLAS COUNTY SURVEYOR

Station: HUBBA - 6


T 25 S, R 7W, Sec 20

Date Set: 3-1-00

Set By (Agency): DCSO


Date Recovered: 3-1-00

Recovered By: RNS SJF

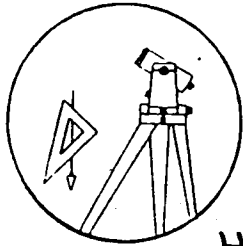

H-084

- Found
- New
- Reset
- Not Found
- Referenced
- Destroyed

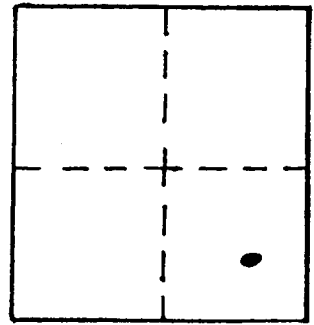

VERTICAL CONTROL

Elevation: 370.91 NGS Line # _____ USGS Line # _____ OSHD Line # _____

Precision: 3rd Agency: DCSO Proj. # 2007 Date: 2000

HORIZONTAL CONTROL CORPSCON6 NAVD88 374.41 FT CS66/53

South Zone O.C.S. 27: Y(Northing) _____ X(Easting) _____

South Zone O.C.S. 83: Y(Northing) 638674 X(Easting) 4110170

Precision: GIS SCALED Agency: DCSO Proj. # _____ Date: 2014

Approx. NAD ⁸³ Geographic Position: Latitude 43° 22' 43" Longitude 123° 33' 01"

DESCRIPTION and TO REACH

FROM THE INTERSECTION OF MELQUA RD (COORD #13A)
AND HUBBARD CRK RD (COORD #6) IN T 25S R 7W SEC 26
PROCEED WESTERLY ALONG HUBBARD CRK RD
4.20 MILE TO MONUMENT ON RIGHT IN TOP OF
CONCRETE CULVERT

DCSO PRILL CAP STAMPED "HUBBA-6 2000"
SET IN A 24" DIA CONCRETE CULVERT.

Reference Marks:

