

OFFICE OF THE
DOUGLAS COUNTY SURVEYOR

Station: INITIAL PT.

T 23 S, R 5W , Sec 4

Date Set: Haines LS#239

Set By (Agency): 1976

Date Recovered: 7/92


Recovered By: TF


Date Recovered: _____

Recovered By: _____

Date Recovered: _____

Recovered By: _____

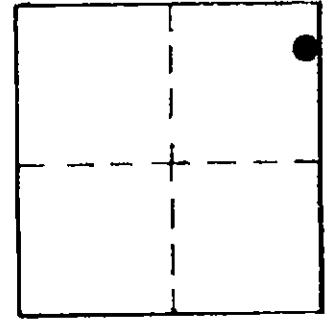

I-012  23S 5W 4
INITIAL PT (not stamped)

NAD 718036.28 4183145.10
83 43°36'11" 123°17'14"

VERTICAL CONTROL

Elevation: _____ NGS Line # _____ USGS Line # _____ OSHD Line # _____

Precision: _____ Agency: _____ Proj. # _____ Date: _____

HORIZONTAL CONTROL

South Zone O.C.S. 27: Y(Northing) 718,070.86 X(Easting) 1,262,184.86

South Zone O.C.S. 83: Y(Northing) _____ X(Easting) _____

Precision: 1/5,000 Agency: DCSO Proj. # 2008 Date: 1980

Approx. NAD 83 Geographic Position: Latitude _____ Longitude _____

DESCRIPTION and TO REACH

SKETCH

Initial point is a 2" x 36" iron pipe, used in the subdivisions North Yoncalla Add. Vol 15 Pg. 55 A&B and 1st Add. to North Yoncalla Vol. 16 Pg. 47

Reference Marks:

Note: For further information, contact the Douglas County Surveyor's Office, Room 205 Douglas County Justice Building, Roseburg, OR 97470. Phone 440-4278. Douglas County residents outside the Roseburg calling area, dial toll free 1-800-452-0991.