OFFICE OF THE
DOUGLAS COUNTY SURVEYOR

k-031 27S 6E 29
KRISTI

NAD 83	557701.97 43°11' 7"	4486351.20 122° 7'51"

Station: KRISTI T 27 S, R 6 E , Sec 29
Set By (Agency): DCSO
Date Set: 1979
Recovered By FLI (DCSO)
Date Recovered 6-15-84
Recovered By O.D.O.T.
Date Recovered 9-10-98 FD FAIR CONDITION
Recovered By
Date Recovered

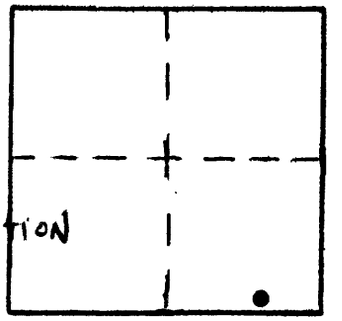

VERTICAL CONTROL

Elevation: _____ NGS Line # _____ USGS Line # _____ OSHD Line # _____
Precision: _____ Agency: _____ Proj. # _____ Date: _____

HORIZONTAL CONTROL OCS 27

South Zone State Plane Coordinates: Y(Northing) 557,739.86 X(Easting) 1,565,389.61
Precision: 1/10,000 Agency: DCSO Proj. # 2008 CS 61/9 Date: OCT 1979
Approximate Geographic Position: Latitude 43°11'08" Longitude 122°07'47"

DESCRIPTION and TO REACH

S.W. corner of intersection of new Hwy 138 and the most northerly Diamond Lake Access road.

B.C. set in 6" bell tile, 9 ft. outside of guardrail.

SKETCH

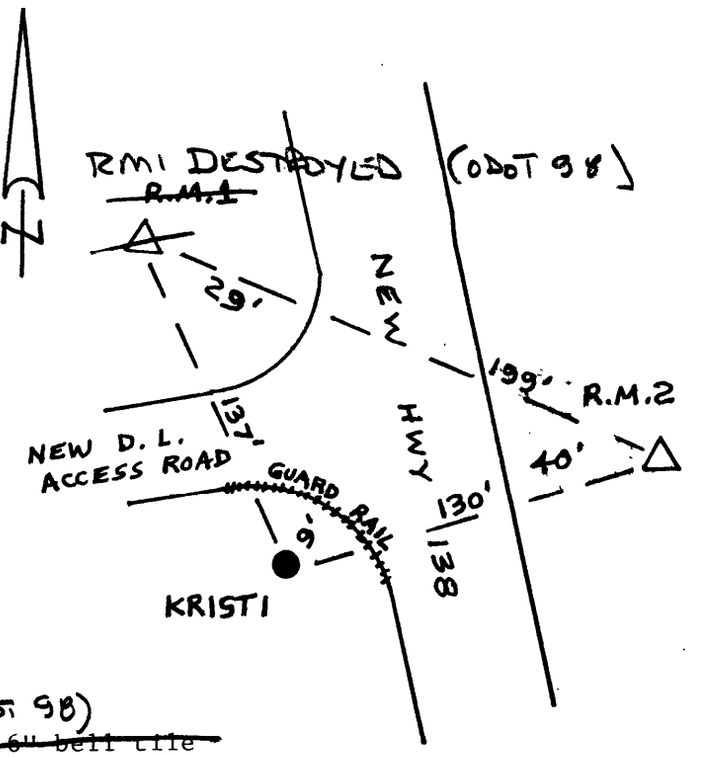

Reference Marks: (RM1 DESTROYED (ODOT 98)
~~KRISTI R.M. 1 B.C. in 6" bell tlie 557,876.49 1,565,391.00~~

KRISTI R.M. 2 B.C. in 6" bell tlie (FD. OK 9/10/98 ODOT)
557,723.37 1,565,518.13

Note: For further information, contact the Douglas County Surveyor's Office, Room 205 Douglas County Justice Building, Roseburg, OR 97470. Phone 440-4278. Douglas County residents outside the Roseburg calling area, dial toll free 1-800-452-0991.