


Date Set: 1997


Set By (Agency): DCSO

Date Recovered: 2-27-97

Recovered By: RWS SJF

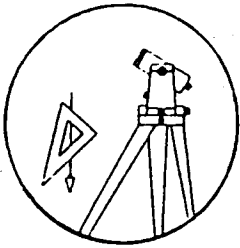

- | | |
|---|---|
| <input checked="" type="checkbox"/> Found | <input checked="" type="checkbox"/> New |
| <input type="checkbox"/> Reset | <input type="checkbox"/> Not Found |
| <input type="checkbox"/> Referenced | <input type="checkbox"/> Destroyed |

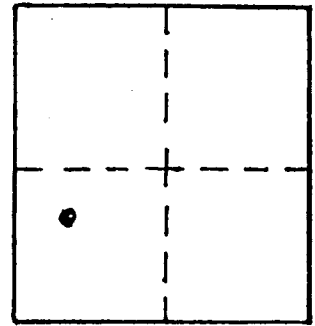

VERTICAL CONTROL

Elevation: 886.70 NGS Line # _____ USGS Line # _____ OSHD Line # _____

Precision: 3rd Agency: DCSO Proj. # 2007 Date: 1997

HORIZONTAL CONTROL CORPSCON6, NAVD88 890.36 FT. CS66154

South Zone O.C.S. 27: Y(Northing) _____ X(Easting) _____

South Zone O.C.S. 83: Y(Northing) 709 406 X(Easting) 4210343

Precision: GIS SCALED Agency: DCSO Proj. # _____ Date: 2014

Approx 27 Geographic Position: Latitude 43° 34' 55" Longitude 123° 10' 57"

DESCRIPTION and TO REACH

A DCSO BRASS CAP STAMPED "MILL TOWN 1997"
IN A 8" DIA BY 40" LONG CONCRETE FILLED
PLASTIC PIPE.

FROM THE INTERSECTION OF CORP #8
(SCOTT'S VALLEY RD) AND CORP #7 (ELKHEAD RD)
IN T22S R4W SEC 31 PROCEED SOUTHERLY
ALONG ELKHEAD RD 3.15 MILES TO MONUMENT
ON LEFT.

Reference Marks:

