OFFICE OF THE
DOUGLAS COUNTY SURVEYOR

Station: HANNAH T 23 S, R 7W, Sec 32

Date Set: 1996

Set By (Agency): PLS 839, BENTZ

Date Recovered: AUG 3, 1999

Recovered By: SJF 9/2/2003

H-095

☐ Found ☑ New

☐ Reset ☐ Not Found

☐ Referenced ☐ Destroyed

VERTICAL CONTROL NGVD 29

Elevation: 212.~~81~~ 67 NGS Line # _____ USGS Line # _____ OSHD Line # _____

Precision: 3 RD Agency: ~~PLS 839~~ DCSO ~~Proj.~~ FILE # ~~1998-0064~~ C.S. 67/1 Date: ~~1996~~ 2003

HORIZONTAL CONTROL CORPSCON6 NAVD88 216.22 FT.

South Zone O.C.S. 27: Y(Northing) _____ X(Easting) _____

South Zone O.C.S. 83: Y(Northing) 693048. X(Easting) 4111148

Precision: GIS SCALED Agency: DCSU Proj. # _____ Date: 2014

Approx. NAD ~~83~~ 27 Geographic Position: Latitude 43°31'40" Longitude 123°33'15"

DESCRIPTION and TO REACH

AN UNMARKED 2 INCH BRASS CAP STAMPED "HANNAH ELEV. 212.81" SET FLUSH IN TOP OF 15 INCH DIAMETER, CONCRETE FILLED, CONCRETE BELLTILE. BELLTILE IS SET FLUSH WITH GROUND (BELL END UP).

FROM THE INTERSECTION OF BULLOCK ROAD (CO. RD. # 57) AND WAGGONER CREEK ROAD (BLM ROAD 23-7-31.0) IN T23S, R7W, SECTION 31 PROCEED SOUTHEASTERLY ALONG BULLOCK ROAD APPROXIMATELY 0.9 MILES TO MONUMENT ON LEFT. THE MONUMENT IS ALSO APPROXIMATELY 200 FEET NORTHWESTERLY ALONG BULLOCK ROAD (CO. RD. #57) FROM THE NORTHERLY ENTRANCE TO MADISON WAYSIDE (A DOUGLAS COUNTY PARK).

Reference Marks:

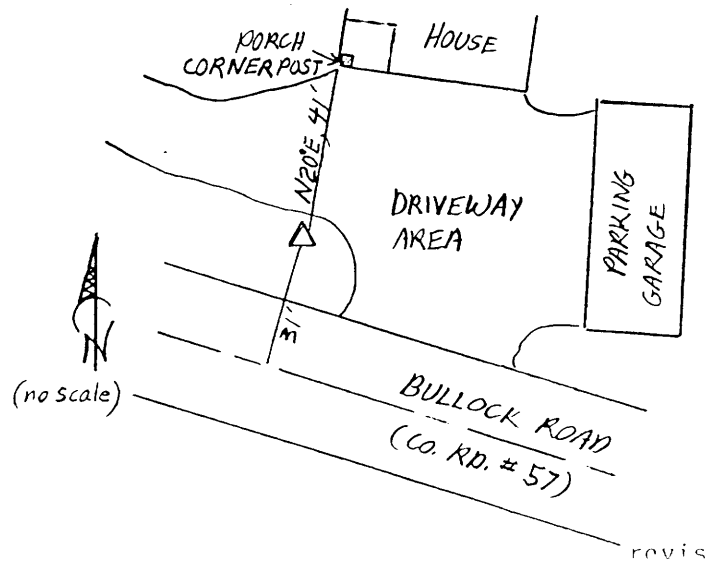

Abridged version keyed into SARS.

revised 12