



Station: OLA-1  
Date Set: 1998  
Set By (Agency): DCSO  
Date Recovered: 11-23-98  
Recovered By: RWS

T 29 S, R 2W, Sec 27

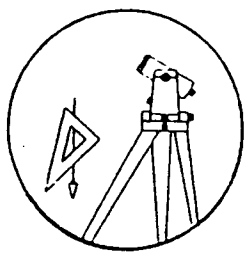

DESIG. O-022

- Found
- Reset
- Referenced
- New
- Not Found
- Destroyed

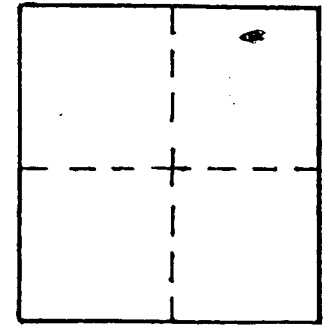

O-022

VERTICAL CONTROL

Elevation: 629.85 NGS Line # \_\_\_\_\_ USGS Line # \_\_\_\_\_ OSHD Line # \_\_\_\_\_  
Precision: 3rd Agency: DCSO Proj. # 2007 Date: 1999

HORIZONTAL CONTROL CORPSCON6 NAVD88 633.31 FT. CS 66/50

South Zone O.C.S. 27: Y(Northing) \_\_\_\_\_ X(Easting) \_\_\_\_\_

South Zone O.C.S. 83: Y(Northing) 541592 X(Easting) 4118445

Precision: GIS SCALED Agency: DCSO Proj. # \_\_\_\_\_ Date: 2014

Approx. NAD <sup>83</sup> Geographic Position: Latitude 43° 06' 48" Longitude 123° 30' 22"

DESCRIPTION and TO REACH

A DCSO BRASS CAP SET IN SOUTHWESTERLY ABUTMENT WALL OF CONCRETE BRIDGE STAMPED "OLA-1 1998"

FROM THE INTERSECTION OF STATE HWY 42 AND ORALLA ROAD (CO RD # 30) IN T29S R71W SEC 27 PROCEED WESTERLY ALONG STATE HWY 42 0.1 MILE TO CONCRETE BRIDGE AND MONUMENT ON LEFT

Reference Marks:

