


OFFICE OF THE
DOUGLAS COUNTY SURVEYOR

P-071 22S 12W 8
PTS 101-12
NAD 752748.63 2432710.70
SS 43°40'28" 124°09'31"

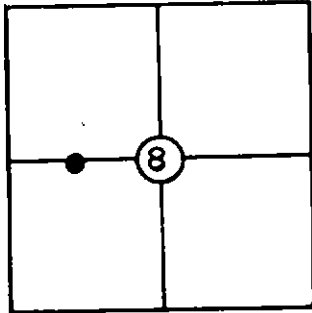

T 22 S, R 12 W, Sec. 8
Station: PTS 101-12
Set By (Agency): DCSO
Date: 1975

VERTICAL CONTROL

Elevation: _____ NGS(USC&GS) Line # _____ USGS Line # _____

Order _____ Agency: _____ Proj. #: _____ Date: _____
Of Precision _____

HORIZONTAL CONTROL


Oregon State Plane Coordinates: Y(Northing) 752,983.68 X(Easting) 1,031,950.22
(South Zone)

(T22S R12W)
Order _____ Agency: DCSO Proj. #: 6004-16 Date: 1975
Of Precision 1/15,000

Approximate Geographic Position: Latitude= 43° 40' 29" Longitude= 124° 09' 37"

DESCRIPTION: A standard DCSO brass cap set
in a conc. filled 6"x36" bell tile buried
flush with ground. 3.7 ft. Westerly of
mailbox, #264, 2.5 ft. NW'ly of telephone
box "T-793", 3.85 ft. N. of sign post,
19.5 ft. S'ly of fog line, 80.3 ft., N 18°W
of power pole "A 6083-14".

SKETCH

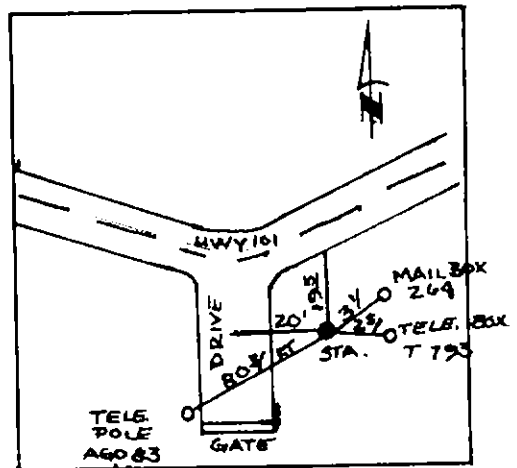

VICINITY: Reedsport area along Hwy 101
South approx. 2.45 mi. SW of Reedsport.

NOTE: For Possible Further Information On This Station, Please Contact The Douglas County Surveyors Office, Rm. 205 Douglas County Justice Bldg., Roseburg, OR. 97470 Phone 672-3311 Ext. 272.. Douglas County residents outside the Roseburg calling area dial toll free 1-800-452-0991.