


2-092 22S 12W 8
PTS 101-13

OFFICE OF THE
DOUGLAS COUNTY SURVEYOR

941 754748.65 3954284.22
83 43°40'47" 124° 09'11"

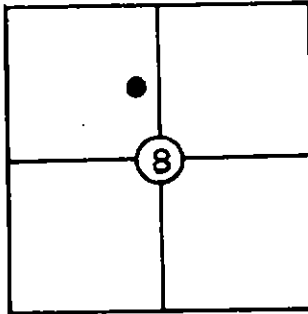

T 22 S, R 12 W, Sec. 8

Station: PTS 101-13

Set By (Agency): DCSO

Date: 1975

VERTICAL CONTROL

Elevation: _____ NGS(USC&GS) Line # _____ USGS Line # _____

Order _____
Of Precision _____ Agency: _____ Proj. #: _____ Date: _____

HORIZONTAL CONTROL

Oregon State Plane Coordinates: Y(Northing) 754,781.65 X(Easting) 1,033,923.54
(South Zone)

(T22S R12W)

Order _____
Of Precision 1/15,000 Agency: DCSO Proj. #: 6004-16 Date: 1975

Approximate Geographic Position: Latitude= 43° 40' 48" Longitude= 124° 09' 11"


DESCRIPTION: A standard DCSO brass cap set

in a conc. filled 6"x36" bell tile buried

flush with the ground. 3.5 ft. South of
sign post, 23.8 ft. Northerly of North
fog line of Hwy 101, approx. 5 ft. above
pavement, 60.0 ft. Easterly of small
creek, 37.5 ft., N30°E of road sign
"CAMPING 1/4 MILE".

TO REACH: Proceed 1.95 mi. SW along Hwy
101 from the intersection with 22nd St.
Monument on North side of Hwy, 5 ft. above
pavement on cut bank.

SKETCH

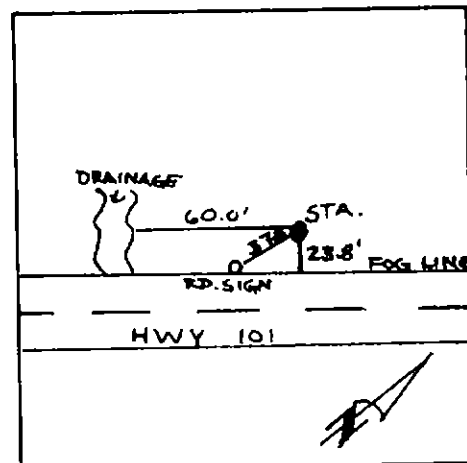

VICINITY: Approx. 1.95 miles SW'ly along Hwy
101 from the intersection of Hwy 101 and
22nd St. in Reedsport.

NOTE: For Possible Further Information On This Station, Please Contact The Douglas County Surveyors Office, Rm. 205 Douglas County Justice Bldg., Roseburg, OR. 97470 Phone 672-3311 Ext. 272. Douglas County residents outside the Roseburg calling area dial toll free 1-800-452-0991.