

Station: PEBBLES

T 26 S, R 4W, Sec 15



Date Set: 1999

Set By (Agency): DCSO

Date Recovered: 5-19-1999

Recovered By: RWS, SJF

- Found New
 Reset Not Found
 Referenced Destroyed

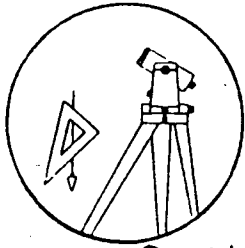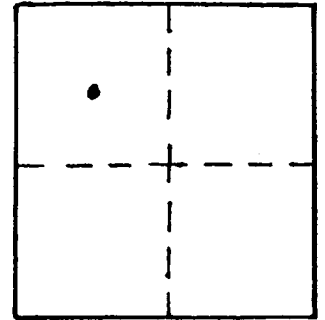

P-115

P-115

VERTICAL CONTROL

Elevation: 685.24 NGS Line # _____ USGS Line # _____ OSHD Line # _____

Precision: 3rd Agency: DCSO Proj. # 2007 Date: 1999

HORIZONTAL CONTROL CORPSCON6 NAVDBB 688.82 FT CS 66137

South Zone O.C.S. 27: Y(Northing) _____ X(Easting) _____

South Zone O.C.S. 83: Y(Northing) 610565 X(Easting) 4212569

Precision: GIS SCALED Agency: DCSO Proj. # _____ Date: 2014

Approx. NAD 83 Geographic Position: Latitude 43° 18' 41" Longitude 123° 09' 43"

DESCRIPTION and TO REACH

FROM THE INTERSECTION OF HWY 139 (DIAMOND LAKE HWY) AND WHISTLER LN RD (CO. RD #223) IN T26S R4W SEC 15, PROCEED NORTH ALONG WHISTLER LN RD 0.5 MILES TO MONUMENT ON RIGHT.

DCSO DRILL CAP STAMPED "PEBBLES 1999" SET IN A CONCRETE WALL.

Reference Marks:

NO SCALE:



E WHISTLER LANE

