

OFFICE OF THE
DOUGLAS COUNTY SURVEYOR

S-048
SAND

2/82

21S 5W 34


NAD 753183.43 4186107.27
83 43°41'59" 123°16'50"

T 21 S, R 5W, Sec. 34

Station: SAND 1979

Set By (Agency): DCSO

Date: 1979

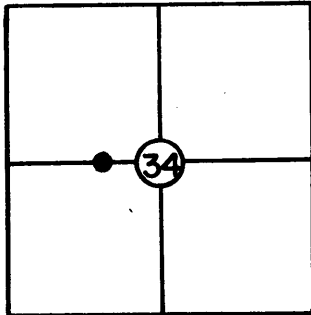

S-048

VERTICAL CONTROL

Elevation: _____ NGS(USC&GS) Line # _____ USGS Line # _____

Order
Of Precision _____ Agency: _____ Proj. #: _____ Date: _____

HORIZONTAL CONTROL

NAD 27
Oregon State Plane Coordinates: Y(Northing) 753,218.24 X(Easting) 1,265,146.47
(South Zone)

(North County)

Order
Of Precision 1/25,000 Agency: DCSO Proj. #: 2008 Date: 1979

Approximate Geographic Position: Latitude= 43° 42' 00" Longitude= 123° 16' 45"


DESCRIPTION: A standard brass cap set in conc.
filled bell tile 6"x39" buried flush with ground
4 ft. northerly of the north guard rail end of
sand creek crossing. 88 ft. westerly of west
end of bridge (sand creek) curbing.

A DCSO disk stamped "SAND RM 1 1979" bears
S 89° 51' 35" E 89.83' (grid)

A DCSO disk stamped "SAND RM 2 1979" bears
S 5° 28' 09" E 52.88' (grid)

VICINITY: 1.25 miles north of Smith River Rd.
along Hwy 99.

SKETCH

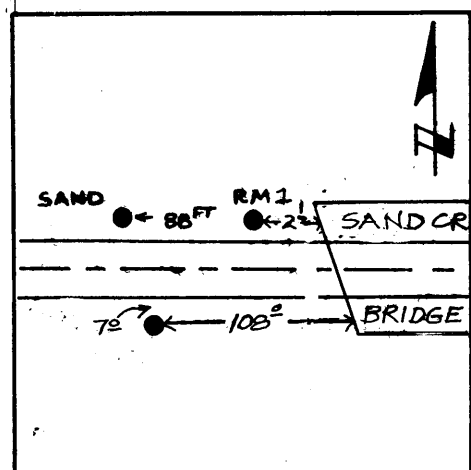

NOTE: For Possible Further Information On This Station, Please Contact The Douglas County Surveyors Office, Rm. 205 Douglas County Justice Bldg., Roseburg, OR. 97470 Phone 672-3311 Ext. 272.. Douglas County residents outside the Roseburg calling area dial toll free 1-800-452-0991.