

OFFICE OF THE

DOUGLAS COUNTY SURVEYOR


S-055
SC-6

22S 12W 1

NAD
83

756798.82
43°41'16"

3975187.76
124° 4'40"

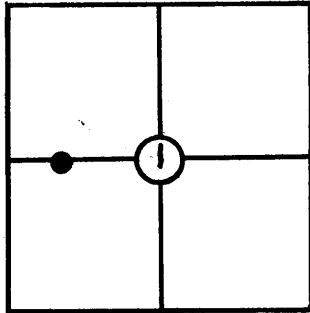

S-055

T 22 S, R 12 W, Sec. 1

Station: SC-6

Set By (Agency): DCSO

Date: 1973

VERTICAL CONTROL NGVD 29

Elevation: 12.444 NGS(USC&GS) Line # _____ USGS Line # _____

(River Floodplain)

Order

Of Precision 2nd Agency: DCSO Proj. #: 2006 Date: 1973

HORIZONTAL CONTROL NAD 27

Oregon State Plane Coordinates: Y(Northing) 756,833.98 X(Easting) 1,054,227.00
(South Zone)

(River Floodplain)

Order

Of Precision 1/25,000 Agency: DCSO Proj. #: 2006 Date: 1973

Approximate Geographic Position: Latitude= 43° 41' 16" Longitude= 124° 04' 36"

DESCRIPTION: A standard DCSO brass cap set

in conc. stamped "SC-6" 18.5 ft. S50°W

from sign post 6.5 ft. Northerly of North

rail. 178.0 ft. from sign "742".

VICINITY: Approx. 9000 ft. along SPRR

Southeasterly from intersection of SPRR
and Winchester Ave. in Reedsport.

NOTE: For Possible Further Information On This Station, Please Contact The Douglas County Surveyors Office, Rm. 205 Douglas County Justice Bldg., Roseburg, OR. 97470 Phone 672-3311 Ext. 272.. Douglas County residents outside the Roseburg calling area dial toll free 1-800-452-0991.

SKETCH

