

OFFICE OF THE
DOUGLAS COUNTY SURVEYOR

Station: SCR-2


T 28 S, R 7W, Sec 23

Date Set: 1998

Set By (Agency): DCSO


Date Recovered: 7-27-98

Recovered By: RWS SJF

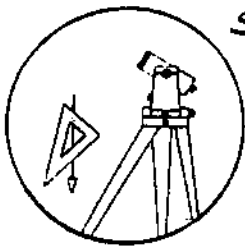

S-179

- Found
- New
- Reset
- Not Found
- Referenced
- Destroyed

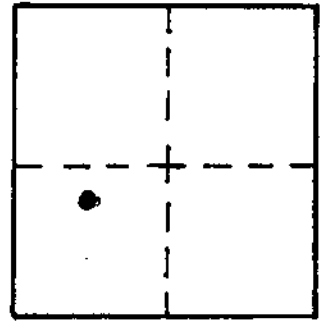

VERTICAL CONTROL NGVD 29

Elevation: 618.80 NGS Line # _____ USGS Line # _____ OSHD Line # _____

Precision: 3rd Agency: DCSO Proj. # 2007 Date: 1998

HORIZONTAL CONTROL

CS 66/49

South Zone O.C.S. 27: Y(Northing) _____ X(Easting) _____

South Zone O.C.S. 83: Y(Northing) _____ X(Easting) _____

Precision: _____ Agency: _____ Proj. # _____ Date: _____

Approx. NAD ²⁷ Geographic Position: Latitude 43° 07' 12" Longitude 123° 29' 46"

DESCRIPTION and TO REACH

2 3/4" DIA DRILL CAP SIMILAR "SCR-2 1998"
IS SET IN AN 8" DIA BY 45" LONG
CONCRETE FILLED BELL TILE, PROTRUS
6 IN ABOVE GROUND
FROM THE INTERSECTION OF ST. HWY. 42 AND STRICKLAND
CANYON ROAD (CD. RD #108) IN T 28 S R 7 W SEC. 27 PROCEED
NORTHERLY ALONG STRICKLAND CANYON ROAD 1.2 MILE TO
MONUMENT ON RIGHT.

Reference Marks:

