

OFFICE OF THE
DOUGLAS COUNTY SURVEYOR

Station: SCR-5

T 28 S, R 7W, Sec 15


Date Set: JULY 1998

Set By (Agency): DCSO


Date Recovered: 7/27/98

Recovered By: _____

- Found
- New
- Reset
- Not Found
- Referenced
- Destroyed

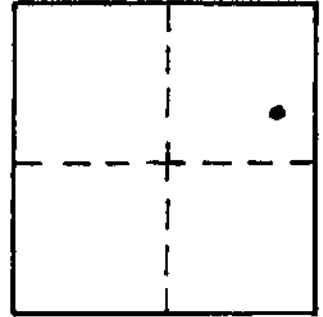

S-182

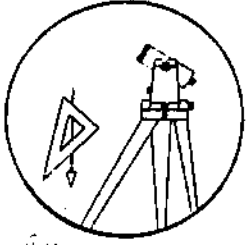

22 9
1 17
2 25

VERTICAL CONTROL NGVD 29

Elevation: 606.80 NGS Line # _____ USGS Line # _____ OSHD Line # _____

Precision: 3rd Agency: DCSO Proj. # 2007 Date: 1998

HORIZONTAL CONTROL CS 69/49

South Zone O.C.S. 27: Y(Northing) _____ X(Easting) _____

South Zone O.C.S. 83: Y(Northing) _____ X(Easting) _____

Precision: _____ Agency: _____ Proj. # _____ Date: _____

Approx. NAD 83 Geographic Position: Latitude 43° 08' 17" Longitude 123° 30' 11"

DESCRIPTION and TO REACH

DCSO DISK STAMPED "SCR-5 1998" SET FLUSH IN TOP
OF CONCRETE FILLED 8x4S INCH CONCRETE BELL TILE
WHICH IS FIRMLY SET AND PROTRUDES 5 INCHES ABOVE GROUND.

FROM THE INTERSECTION OF STATE HIGHWAY 42 AND STRICKLAND
CANYON ROAD (LOCAL # 108) IN T 28S, R 7W, SEC 27 PROCEED NORTHERLY
AND EASTERLY ALONG STRICKLAND CANYON ROAD APPROXIMATELY
3.15 MILES TO MONUMENT ON LEFT.

Reference Marks:

