

1/30/01

OFFICE OF THE

t-024  
TEE PEE

22S 5W 8

DOUGLAS COUNTY SURVEYOR


NAD 741346.62 4176796.22  
83 43°39'59" 123°18'51"

T 22 S, R 5W, Sec. 8

Station: Tee Pee

Set By (Agency): DCSO

Date: 1978, (FD OK 1991), FD OK 8/00 DCSO

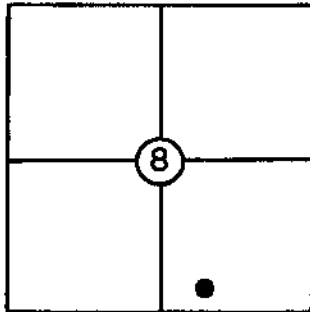

VERTICAL CONTROL

Elevation: 305.04 NGS(USC&GS) Line # \_\_\_\_\_ USGS Line # \_\_\_\_\_

Order  
Of Precision 3rd Agency: DCSO Proj. #: \_\_\_\_\_ Date: 8/2000

HORIZONTAL CONTROL

Oregon State Plane Coordinates: Y(Northing) 741,381.47 X(Easting) 1,255,835.61  
(South Zone)

Order (North County)  
Of Precision 1/25,000 Agency: DCSO Proj. #: 2008 Date: 1979

Approximate Geographic Position: Latitude= 43° 40' 00" Longitude= 123° 18' 47"

DESCRIPTION: B.C. in belltile 2" below surface

Cap is 25" E. of Hwy. 99 centerline and 25'

S. of a driveway centerline. RM 1 and RM 2

are B.C. in belltile. Witness posts set 3'

from monument and RM's. Cap is stamped

"Tee Pee 1978".

A DCSO disk stamped "TEEPEE RM 1 1979" bears  
N 68° 24' 04" W 50.42' (grid)

A DCSO disk stamped "TEEPEE RM 2 1979" bears  
S 22° 31' 34" W 118.92' (grid)

VICINITY: Drain area along Hwy. 99. Approx.

0.40 mi. NE'stly along Hwy. 99 from intersection  
of Hwy. 99 and Hwy. 38.

NOTE: For Possible Further Information On This Station, Please Contact The Douglas County Surveyors Office, Rm. 205 Douglas County Justice Bldg., Roseburg, OR. 97470 Phone 672-3311 Ext. 272. Douglas County residents outside the Roseburg calling area dial toll free 1-800-452-0991.

SKETCH

