


OFFICE OF THE  
DOUGLAS COUNTY SURVEYOR

u-014  
U-13

25S 7W 6

NAD 654011.45 4106628.85  
83 43°25'13" 123°34' 1"

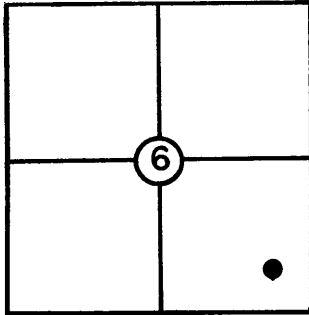

T 25 S, R 7W, Sec. 6

Station: U-13

Set By (Agency): DCSO

Date: 1972

VERTICAL CONTROL

**NGVD 29**  
Elevation: 299.804 NGS(USC&GS) Line # \_\_\_\_\_ USGS Line # \_\_\_\_\_

Order  
Of Precision 2nd Agency: DCSO Proj. #: 2006 Date: 1973

HORIZONTAL CONTROL

**NAD 27**  
Oregon State Plane Coordinates: Y(Northing) 654,045.96 X(Easting) 1,185,669.89  
(South Zone)

Order  
Of Precision 1/25,000 Agency: DCSO Proj. #: 2006 Date: 1972

Approximate Geographic Position: Latitude= \_\_\_\_\_ Longitude= \_\_\_\_\_

DESCRIPTION: FROM UMPQUA POST OFFICE, GO

11.3 MI. N. POINT IS APPROX. 20 FT.


W. OF ROAD EDGE; BRASS CAP SET IN ROCK.

\_\_\_\_\_  
\_\_\_\_\_  
\_\_\_\_\_  
\_\_\_\_\_  
\_\_\_\_\_

VICINITY: NEAR TYEE SETTLEMENT BLM BRIDGE

IN SIGHT.

SKETCH

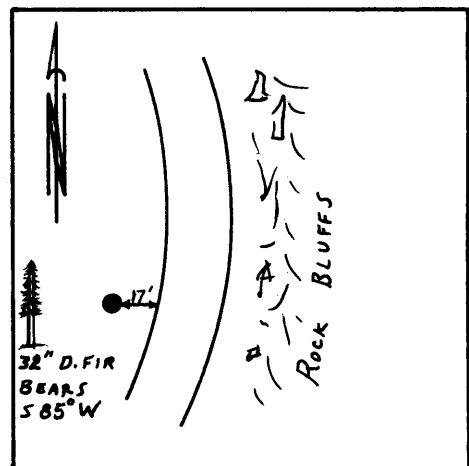

NOTE: For Possible Further Information On This Station, Please Contact The Douglas County Surveyors Office, Rm. 205 Douglas County Justice Bldg., Roseburg, OR. 97470 Phone 672-3311 Ext. 272.. Douglas County residents outside the Roseburg calling area dial toll free 1-800-452-0991.