


OFFICE OF THE
DOUGLAS COUNTY SURVEYOR

u-040
U-38

23S 7W 29

NAD 696790.15 4112999.64
83 43°32'18" 123°32'56"

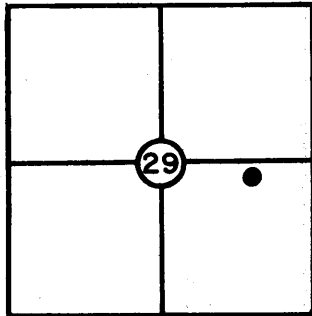

T 23 S, R 7W, Sec. 29

Station: U-38

Set By (Agency): DCSO

Date: 1972

NGVD 29

VERTICAL CONTROL

Elevation: 396.195 NGS(USC&GS) Line # _____ USGS Line # _____

Order
Of Precision 2nd Agency: DCSO Proj. #: 2006 Date: 1972

NAD 27

HORIZONTAL CONTROL

Oregon State Plane Coordinates: Y(Northing) 696,824.94 X(Easting) 1,192,039.91
(South Zone)

Order
Of Precision 1/25,000 Agency: DCSO Proj. #: 2006 Date: 1972

Approximate Geographic Position: Latitude= _____ Longitude= _____

DESCRIPTION: Bronze disk set in concrete

belltile with survey signpost alongside.


12 ft. above Rd. Cutbank and 3 ft. from

fenceline.

VICINITY: From junction of Tyee Rd. and Hwy.

138 go W'stly 6.6 mi.

SKETCH

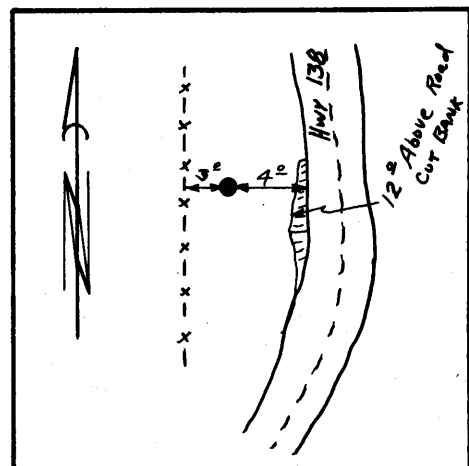

NOTE: For Possible Further Information On This Station, Please Contact The Douglas County Surveyors Office, Rm. 205 Douglas County Justice Bldg., Roseburg, OR. 97470 Phone 672-3311 Ext. 272.. Douglas County residents outside the Roseburg calling area dial toll free 1-800-452-0991.