


OFFICE OF THE
DOUGLAS COUNTY SURVEYOR

u-042
U-40

23S 7W 19

NAD 702744.22 4107972.40
83 43°33'14" 123°34' 7"

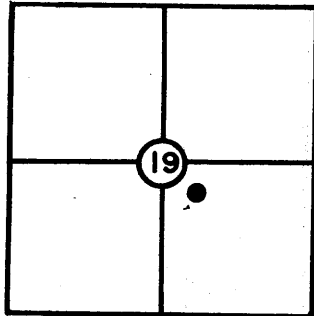

T 23 S, R 7W, Sec. 19

Station: U-40

Set By (Agency): DCSO

Date: 1972

NGVD 29

VERTICAL CONTROL

Elevation: 255.450 NGS(USC&GS) Line # _____ USGS Line # _____

Order
Of Precision 2nd Agency: DCSO Proj. #: 2006 Date: 1972

DCS 27

HORIZONTAL CONTROL

Oregon State Plane Coordinates: Y(Northing) 702,779.01 X(Easting) 1,187,012.58
(South Zone)


Order
Of Precision 1/10,000 Agency: DCSO Proj. #: 2006 Date: 1972

Approximate Geographic Position: Latitude=43°33'15" Longitude=123°34'03"

DESCRIPTION: From Hwy. 138 at Kellogg, Cont.

W. 0.65 mi. on Bullock Rd. Sta is a bronze
cap in concrete belltile 8 ft. S. and 6 ft.
above Rd. edge near fence corner.

SKETCH

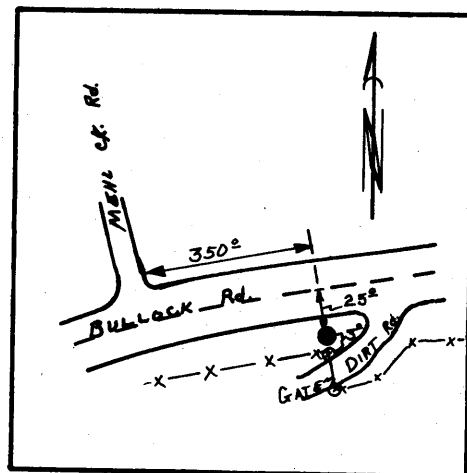

VICINITY: Kellogg W'stly on Bullock Rd.

NOTE: For Possible Further Information On This Station, Please Contact The Douglas County Surveyors Office, Rm. 205 Douglas County Justice Bldg., Roseburg, OR. 97470 Phone 672-3311 Ext. 272.. Douglas County residents outside the Roseburg calling area dial toll free 1-800-452-0991.