


OFFICE OF THE

u-044
U-42

23S 7W 28

DOUGLAS COUNTY SURVEYOR

NAD 696679.43 4118790.29
83 43°32'19" 123°31'38"

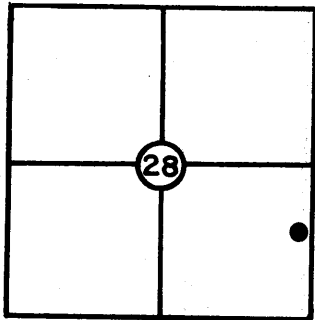

T 23 S, R 7W, Sec. 28

Station: U-42

Set By (Agency): DCSO

Date: 1972

U-044

VERTICAL CONTROL

NGVD 29

Elevation: 199.218 NGS(USC&GS) Line # _____ USGS Line # _____

Order Of Precision 2nd Agency: DCSO Proj. #: 2006 Date: 1974

HORIZONTAL CONTROL

NAD 27

Oregon State Plane Coordinates: Y(Northing) 696,714.24 X(Easting) 1,197,830.57
(South Zone)

Order Of Precision 1/10,000 Agency: DCSO Proj. #: 2006 Date: 1972


Approximate Geographic Position: Latitude= _____ Longitude= _____

DESCRIPTION: From junction of Hwy. 138 and
Maupin Rd. go E. 1.8 mi. Sta. is 4 ft.

M. on bank of Rd. Orchard lies to S. of Rd.
Sta. is bronze disk set in concrete belltile.

VICINITY: On Maupin Rd. E. of Kellogg.

SKETCH

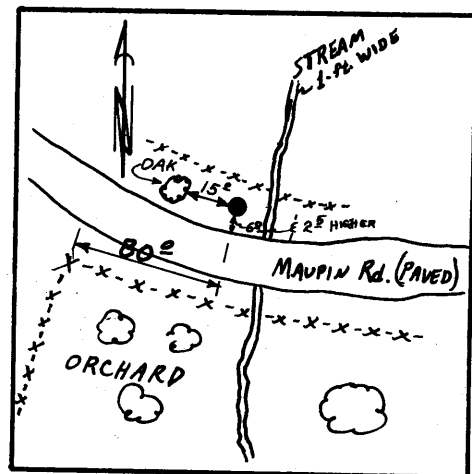

NOTE: For Possible Further Information On This Station, Please Contact The Douglas County Surveyors Office, Rm. 205 Douglas County Justice Bldg., Roseburg, OR. 97470 Phone 672-3311 Ext. 272.. Douglas County residents outside the Roseburg calling area dial toll free 1-800-452-0991.