u-046 235 7W 22
U-44

OFFICE OF THE

DOUGLAS COUNTY SURVEYOR

NAD 83 701779.40 43°33'11" 4124267.05 123°30'26"

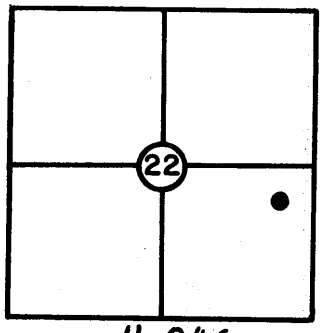

U-046

T 23 S, R 7W, Sec. 22

Station: U-44

Set By (Agency): DCSO

Date: 1972

NGVD 29

VERTICAL CONTROL

Elevation: 198.856 NGS(USC&GS) Line # _____ USGS Line # _____

Order Of Precision 2nd Agency: DCSO Proj. #: 2006 Date: 1975

NAD 27

HORIZONTAL CONTROL

Oregon State Plane Coordinates: (South Zone) Y(Northing) 701,814.27 X(Easting) 1,203,307.25

Order Of Precision 1/10,000 Agency: DCSO Proj. #: 2006 Date: 1972

Approximate Geographic Position: Latitude= _____ Longitude= _____

DESCRIPTION: From junction of Hwy. 138 and Maupin Rd. Go E'stly 4.0 mi. Sta. is 4 ft. N. of Rd. Near fenceline. Sta. is a standard bronze disk set in concrete belltile.

SKETCH

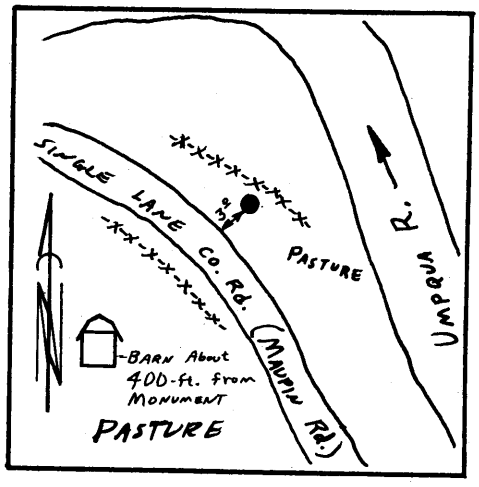

VICINITY: Maupin Rd. E. of Kellogg.

NOTE: For Possible Further Information On This Station, Please Contact The Douglas County Surveyors Office, Rm. 205 Douglas County Justice Bldg., Roseburg, OR. 97470 Phone 672-3311 Ext. 272.. Douglas County residents outside the Roseburg calling area dial toll free 1-800-452-0991.