

OFFICE OF THE

DOUGLAS COUNTY SURVEYOR

u-049
U-47

23S 7W 6


NAD 716413.62 4108519.21
83 43°35'30" 123°34' 7"

T 23 S, R 7W, Sec. 6

Station: U 47

Set By (Agency): DCSO

Date: 1972

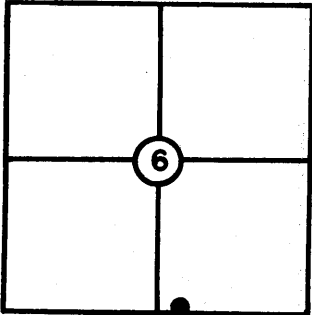

NGVD 29

U-049

346.88

VERTICAL CONTROL

Elevation: 346.875 NGS(USC&GS) Line # _____ USGS Line # _____

Order Of Precision 3rd Agency: DCSO Proj. #: 2006 Date: 1972

HORIZONTAL CONTROL

DCS 27


Oregon State Plane Coordinates: Y(Northing) 716,448.50 X(Easting) 1,187,559.16
(South Zone)

Order Of Precision 1/10,000 Agency: DCSO Proj. #: 2006 Date: 1972

Approximate Geographic Position: Latitude= 43°35'30" Longitude= 123°34'02"

DESCRIPTION: Bronze disk set in concrete
belltile, Survey marker alongside. On top
of high cut bank. 50 ft. above rd. and 3 ft.
from fence.

SKETCH

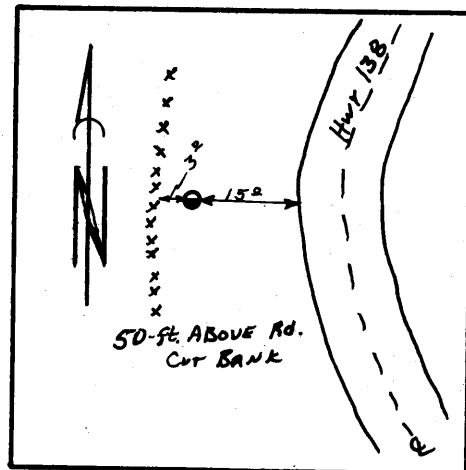

VICINITY: From Junction of Tyee Rd. and Hwy.
138 go W'stly 10.3 mi.

NOTE: For Possible Further Information On This Station, Please Contact The Douglas County Surveyors Office, Rm. 205 Douglas County Justice Bldg., Roseburg, OR. 97470 Phone 672-3311 Ext. 272.. Douglas County residents outside the Roseburg calling area dial toll free 1-800-452-0991.