


OFFICE OF THE
DOUGLAS COUNTY SURVEYOR

u-050
U-48

23S 8W 11

NAD 714233.69 4098613.47
83 43°35' 4" 123°36'20"

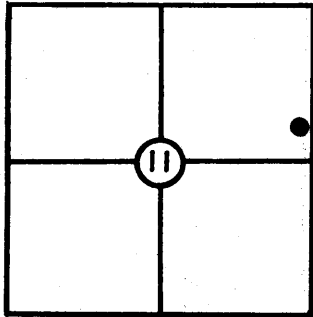

T 23 S, R 8W, Sec. 11

Station: U-48

Set By (Agency): DCSO

Date: 1972

U-050

VERTICAL CONTROL

NGVD 29

Elevation: 152.24 NGS(USC&GS) Line # _____ USGS Line # _____

Order
Of Precision 3rd Agency: RLS 1076 Proj. #: _____ Date: 1991

HORIZONTAL CONTROL

NAD 27


Oregon State Plane Coordinates: Y(Northing) 714,268.45 X(Easting) 1,177,653.54
(South Zone)

Order
Of Precision 1/10,000 Agency: DCSO Proj. #: 2006 Date: 1972

Approximate Geographic Position: Latitude= _____ Longitude= _____

DESCRIPTION: From junction of Henderer and
Mehl Crk. Rd. continue S'thly 5.0 mi on Mehl
Crk. Rd Sta. is bronze cap in concrete bell-
tile N. of road 4 ft. from fenceline and 20
ft. from centerline.

SKETCH

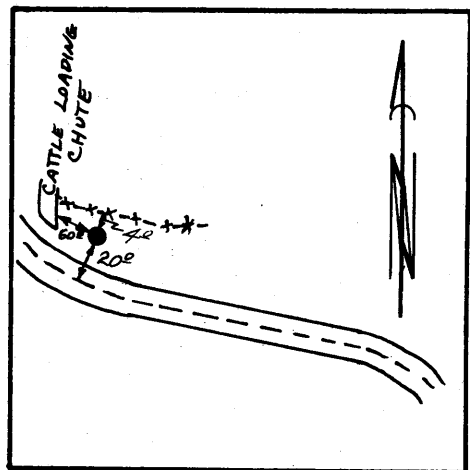

VICINITY: Meth Crk. Rd. midway between
Elkton and Kellogg.

NOTE: For Possible Further Information On This Station, Please Contact The Douglas County Surveyors Office, Rm. 205 Douglas County Justice Bldg., Roseburg, OR. 97470 Phone 672-3311 Ext. 272.. Douglas County residents outside the Roseburg calling area dial toll free 1-800-452-0991.