


OFFICE OF THE
DOUGLAS COUNTY SURVEYOR

u-053 22S 7W 31
U-51-A
NAD 723000.48 4105520.47
83 43°36'34" 123°34'51"

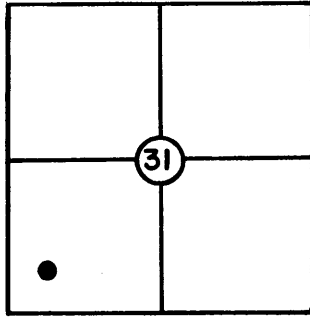

U-053

VERTICAL CONTROL

T 22 S, R 7W, Sec. 31

Station: U-51-A

Set By (Agency): DCSO

Date: 1973

Elevation: _____ NGS(USC&GS) Line # _____ USGS Line # _____

Order
Of Precision _____ Agency: _____ Proj. #: _____ Date: _____

HORIZONTAL CONTROL

NAD 27

Oregon State Plane Coordinates: Y(Northing) 723,035.39 X(Easting) 1,184,560.29
(South Zone)

Order
Of Precision 1/10,000 Agency: DCSO Proj. #: 2006 Date: 1972

Approximate Geographic Position: Latitude= _____ Longitude= _____

DESCRIPTION: Set 3'x2'x1.5' rock with B.C.

2 mi. S. of Elkton. From junction go W'stly

0.75 mi. on Wells Rd. Station is 3' E.


of W. right of way fence on an approx. 8'

cut bank.

VICINITY: Junction Wells Rd. (Known as D.L.

Phipps Nursery Rd.) and Hwy. 138.

SKETCH

 

NOTE: For Possible Further Information On This Station, Please Contact The Douglas County Surveyors Office, Rm. 205 Douglas County Justice Bldg., Roseburg, OR. 97470 Phone 672-3311 Ext. 272.. Douglas County residents outside the Roseburg calling area dial toll free 1-800-452-0991.