


OFFICE OF THE
DOUGLAS COUNTY SURVEYOR

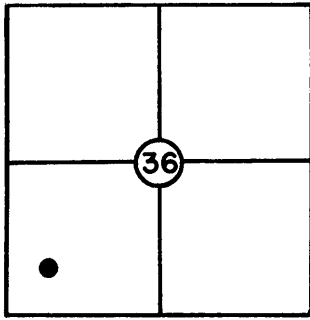

T 21 S, R 12 W, Sec. 36

Station: U - 94

Set By (Agency): DCSO

Date: 1973

DESIG.
U-096

U-096

NGVD 29

VERTICAL CONTROL

Elevation: 73.860 NGS(USC&GS) Line # _____ USGS Line # _____

Order
Of Precision 2nd Agency: DCSO Proj. #: 2006 Date: 1973

HORIZONTAL CONTROL

Oregon State Plane Coordinates: Y(Northing) _____ X(Easting) _____
(South Zone)

Order
Of Precision _____ Agency: _____ Proj. #: _____ Date: _____

Approximate Geographic Position: Latitude= _____ Longitude= _____

DESCRIPTION: From intersection of Coast hwy. 101

& State hwy. 38 in Reedsport, proceed E'stly

on hwy. 38 towards Scottsburg 1.2 mi. to Station

on the left. The station is a standard

brasscap approx. 80 ft. W. of the end of the

guardrail on the N. side of hwy 38, 50 ft.

N. of C. of hwy. 38 & 2 ft. S.E 'stly from


a steel fence post w/survey witness sign

attached.

VICINITY: Approx. 1.2 mi. E. of Reedsport

along State hwy. 38.

SKETCH

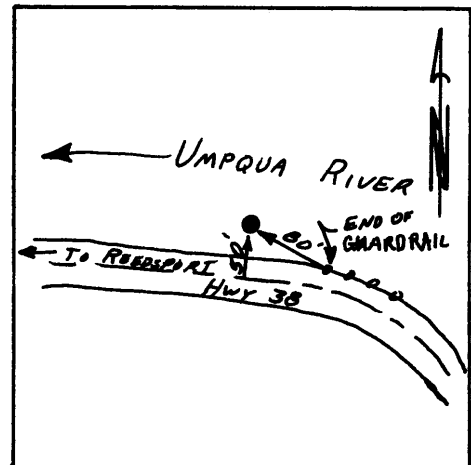

NOTE: For Possible Further Information On This Station, Please Contact The Douglas County Surveyors Office, Rm. 205 Douglas County Justice Bldg., Roseburg, OR. 97470 Phone 672-3311 Ext. 272. Douglas County residents outside the Roseburg calling area dial toll free 1-800-452-0991.