DOUGLAS COUNTY SURVEYOR'S OFFICE

Designation: U-147 Station: U 267 T 29S R 6W S 11 ¼ NE

Date Set: 1934 Set by (Agency): USC + GS

Date Recovered: 12/27/02 Recovered by: RWS

☒ Found ☐ New ☐ Reset

☐ Not Found ☐ Referenced ☐ Destroyed

VERTICAL CONTROL

NGVD 29 Elevation: 563.652 Feet File # CS 66/59

Precision: 1ST Agency: USC+GS Project: LINE #6 Date: 1957

NAVD 88 Elevation: 567.098 FT File #

Precision: CORPSCON6 NAVD88 Agency: Project: Date:

HORIZONTAL CONTROL - south zone

N E Datum/Adj.: 27 Precision: SCALED

Lat: 43°04' 07" Long: 123° 22' 19" Agency: File # Date:

N 524076 E 4153716 Datum/Adj.: 83 Precision: GIS SCALED

Lat: Long: Agency: DCSO File # Date: 2014

N E Datum/Adj.: Precision:

Lat: Long: Agency: File # Date:

N E Datum/Adj.: Precision:

Lat: Long: Agency: File # Date:

DESCRIPTION AND TO REACH

FROM THE INTERSECTION OF CO. RD # 387 (OLD HWY 99 S.) AND CO. RD # 105 (CLARKS BRANCH RD) IN T29S R6W SEC 2 PROCEED SOUTHERLY ALONG OLD HWY 99 S. 0.85 MILES TO MONUMENT ON RIGHT.

USC+GS BRASS CAP IN 1 FT SQUARE CONCRETE POST FLUSH WITH GROUND STAMPED "U267 563 1934".
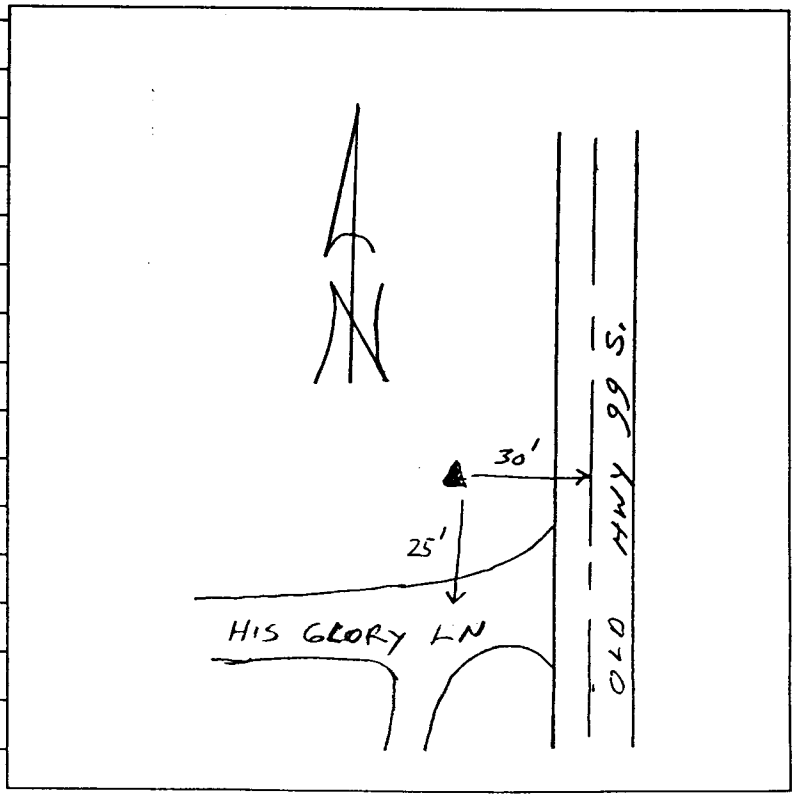
4153716.09
524076.50