


OFFICE OF THE  
DOUGLAS COUNTY SURVEYOR


Station: VIRG1  
Date Set: 1-5-1999  
Set By (Agency): DCSO  
Date Recovered: 1-6-1999  
Recovered By: RWS STI

T 30 S, R 5W, Sec 27

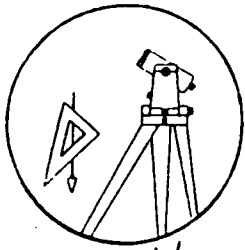

V-035

- Found
- New
- Reset
- Not Found
- Referenced
- Destroyed

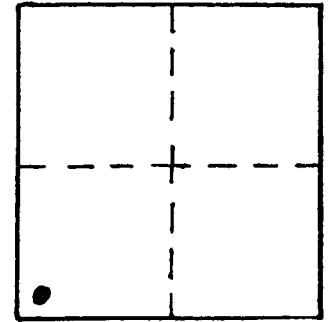

V-035

VERTICAL CONTROL CORPSCON6 NAVDB8 770.59 FT.

Elevation: 767.20 NGS Line # \_\_\_\_\_ USGS Line # \_\_\_\_\_ OSHD Line # \_\_\_\_\_

Precision: 3rd Agency: DCSO Proj. # 2007 Date: 1999

HORIZONTAL CONTROL

South Zone O.C.S. 27: Y(Northing) \_\_\_\_\_ X(Easting) \_\_\_\_\_

South Zone O.C.S. 83: Y(Northing) 471877 X(Easting) 4176615

Precision: G15 SCALED Agency: DCSO Proj. # \_\_\_\_\_ Date: 2014

Approx. NAD 83 Geographic Position: Latitude 42° 55' 39" Longitude 123° 16' 41"

DESCRIPTION and TO REACH

A DCSO BRASS CAP STAMPED "VIRG1 1999"  
SET IN CONCRETE CURB.

FROM THE INTERSECTION OF STATE HWY 29  
AND 1ST STREET IN T30S R5W SEC 27  
(IN CANYONVILLE) PROCEED WESTERLY ALONG  
1ST STREET APPROX 0.1 MILES TO MONUMENT  
ON RIGHT.

Reference Marks:

