

Station: WHOOPEE

T 28 S, R 6W, Sec 3


Date Set: 1997

Set By (Agency): DCLPW


Date Recovered: 6-15-98

Recovered By: RUS SIF

W-061

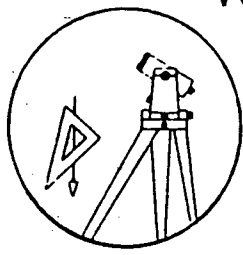

- Found New
- Reset Not Found
- Referenced Destroyed

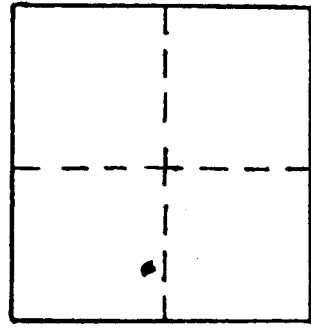

VERTICAL CONTROL NGVD 29

Elevation: 493.272 NGS Line # 4 USGS Line # _____ OSHD Line # _____

Precision: 2nd Agency: DCSO Proj. # 2007 Date: 1998

HORIZONTAL CONTROL CORPSCON6 NAVD88 496,708 FT. CS 66/66

South Zone O.C.S. 27: Y(Northing) _____ X(Easting) _____

South Zone O.C.S. 83: Y(Northing) 557777 X(Easting) 4149063

Precision: GIS SCALED Agency: DCSO Proj. # _____ Date: 2014

Approx. NAD 83 Geographic Position: Latitude 43° 09' 30" Longitude 123° 23' 37"

DESCRIPTION and TO REACH

GO TO THE CONCRETE BRIDGE OVER THE SOUTH
UMPUA RIVER IN GREEN ON HAPPY VALLEY ROAD,
IN T 28 S 6W, SEC 3

A DCLPW BRASS CAP NEAR NORTH EAST CORNER
OF BRIDGE ON TOP OF CONCRETE RAIL, STAMPED
"WHOOPEE 1998"

Reference Marks:

