OFFICE OF THE

DOUGLAS COUNTY SURVEYOR

W-070

Station: WKP 12 RESET T 29 S, R 7W, Sec 16

Date Set: JAN. 06, 1998

Set By (Agency): DCSO

Date Recovered: 01/06/98

Recovered By: SJF, JAP

☐ Found ☐ New

☑ Reset ☐ Not Found

☐ Referenced ☐ Destroyed

W-070

VERTICAL CONTROL CORPSCON6 NAVD88 764.81 FT.

Elevation: 761.38 NGS Line # ____ USGS Line # ____ OSHD Line # ____

Precision: 3rd Agency: DCSO Proj. # 2007 CS 66/50 Date: 1999

HORIZONTAL CONTROL

South Zone O.C.S. 27: Y(Northing) ____ X(Easting) ____

South Zone O.C.S. 83: Y(Northing) 516827 X(Easting) 4108181

Precision: GIS SCALED Agency: DCSO Proj. # ____ Date: 2014

Approx. NAD ~~83~~ 27 Geographic Position: Latitude 43° 02' 39" Longitude 123° 32' 28"

DESCRIPTION and TO REACH

A STANDARD DCPWD DISK MARKED "WKP 12 RESET 1998" SET FLUSH IN TOP OF SOUTHWEST WINGWALL OF NEW CONCRETE BRIDGE OVER OLLALA CREEK.

FROM THE INTERSECTION OF OLALLA RD. (CO. RD. #38) AND IRELAND RD. (CO. RD. #140) IN T29S, R7W, SEC 8 PROCEED SOUTHERLY ALONG OLALLA RD. APPROXIMATELY 1.85 MILES TO MONUMENT ON RIGHT.

Reference Marks:

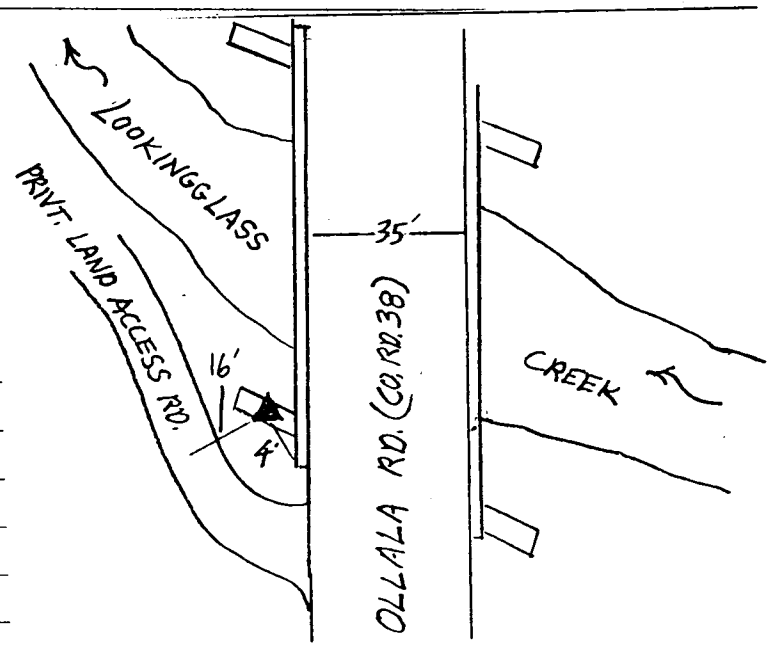

revised 12/9