OFFICE OF THE
DOUGLAS COUNTY SURVEYOR

X-040

Station: X-040
Date Set: 1992
Set By (Agency): DCSO
DCSO Designation: X-040
Date Recovered: 7\10\92
Recovered By: TF HS
Date Recovered: _____
Recovered By: _____
Date Recovered: _____
Recovered By: _____

T 29 S, R 3 W, Sec 15

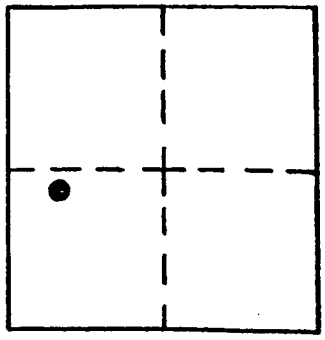

VERTICAL CONTROL CORPSCON6 NAVD88 1185.851 FT.
Elevation: 1182.354 ft. NGS Line # _____ USGS Line # _____ OSHD Line # _____
Precision: 2ND ORDER Agency: DCSO Proj. # 2007 CS 66/47 Date: 1992

HORIZONTAL CONTROL
O.C.S. 27 Y(Northing): _____ O.C.S. 83 Y(Northing): 514335
South Zone X(Easting): _____ South Zone X(Easting): 4238058
Precision: GIS SCALED Agency: DCSO Proj. # _____ Date: 2014
~~Approx~~. NAD ~~83~~ 27 Geographic Position: Latitude 43°02'58" Longitude 123°03'19"
scaled

Set: A standard DCSO disk stamped "X-040 1992" set in a 6" x 36" corrugated sewer pipe protruding 4" from the ground and filled with concrete.

To reach: From the intersection of South Myrtle Rd. (Co.Rd.#18) and Riverside Dr. (Co.Rd.#18A) in T29S R5W sec. 23, continue on South Myrtle Rd. to MP 12.6 or from the intersection of Weaver Creek Rd. (BLM RD.#29-30-16) and South Myrtle Rd. (in T29S R3W sec. 16) continue on South Myrtle Rd. 0.7 mi. to mon. on the right.

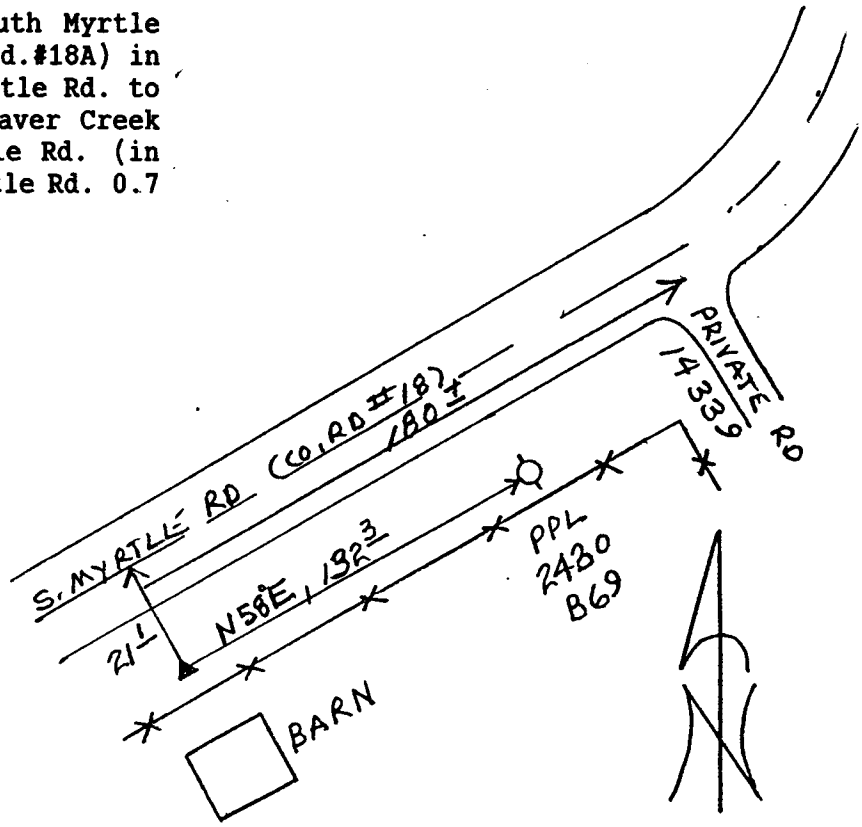


Note: For possible further information contact the Douglas County Surveyors Office, Room 205 Douglas County Justice Building, Roseburg, OR 97470. Phone 440-4272. Douglas County residents outside the Roseburg calling area, dial toll free 1-800-477-0991.