OFFICE OF THE
DOUGLAS COUNTY SURVEYOR

Station: Y246 RESET T 22 S, R 8 , Sec 9
Date Set: 11-22-99
Set By (Agency): DCSO
Date Recovered: 11-22-99
Recovered By: RWS SJF

☐ Found ☒ New
☐ Reset ☐ Not Found
☐ Referenced ☐ Destroyed

Y-028

VERTICAL CONTROL NGVD 29
Elevation: 90.247 NGS Line # ____ USGS Line # ____ OSHD Line # ____
Precision: 2nd Agency: DCSO Proj. # 2007 Date: 1999
HORIZONTAL CONTROL CORPCONG NAVD88 93.882 FT
South Zone O.C.S. 27: Y(Northing) ____ X(Easting) ____
South Zone O.C.S. 83: Y(Northing) 746544 X(Easting) 4087500
Precision: GIS SCALED Agency: DCSO Proj. # ____ Date: 2014
Approx. NAD ~~83~~ 27 Geographic Position: Latitude 43° 40' 21" Longitude 123° 39' 02"

DESCRIPTION and TO REACH

DCSO DRILL CAP STAMPED "Y246 RESET 1999" SET IN SOUTH EAST CORNER OF CONCRETE BRIDGE RAIL.

FROM THE INTERSECTION OF PARADISE CREEK ROAD (BLM 22-8-9) AND STATE HWY 38 IN T22S, R8W, SEC. 9 PROCEED SOUTHERLY ALONG STATE HWY 38 APPOX 0.1 MILES TO MONUMENT ON LEFT.

APPROX. 8.3 MILES NW OF ELKTON.

ign

Reference Marks:

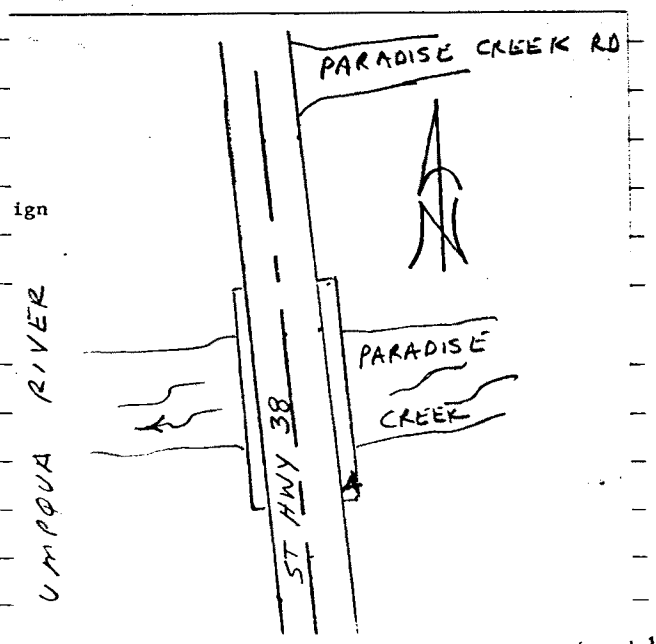

revised 12/