DOUGLAS COUNTY SURVEYOR'S OFFICE

Designation: Z-018 Station: Z 596 1965 - RESETT 27 S R 6 W S 35 ¼ A

Date Set: 2002 Set by (Agency): OSHD

Date Recovered: 1/2002 Recovered by: OSHD

☐ Found ☐ New ☒ Reset

☐ Not Found ☐ Referenced ☐ Destroyed

VERTICAL CONTROL

NGVD 29 Elevation: 488.12 Feet File # _____

Precision: 3rd Agency: OSHD Project: _____ Date: 2002

NAVD 88 Elevation: 491.59 FT. File # _____

Precision: CORPSCON6 NAVD88 Agency: _____ Project: _____ Date: _____

HORIZONTAL CONTROL - south zone

N _____ E _____ Datum/Adj.: 27 Precision: SCALED

Lat: 43° 11' 00" Long: 123° 22' 23" Agency: _____ File # _____ Date: _____

N _____ E _____ Datum/Adj.: 83 Precision: GIS

Lat: 43° 10' 59.7" Long: 123° 22' 27.3" Agency: _____ File # _____ Date: _____

N 565857 E 4154858 Datum/Adj.: 83 Precision: GIS SCALED

Lat: _____ Long: _____ Agency: DCSO File # _____ Date: 2014

N _____ E _____ Datum/Adj.: _____ Precision: _____

Lat: _____ Long: _____ Agency: _____ File # _____ Date: _____

DESCRIPTION AND TO REACH
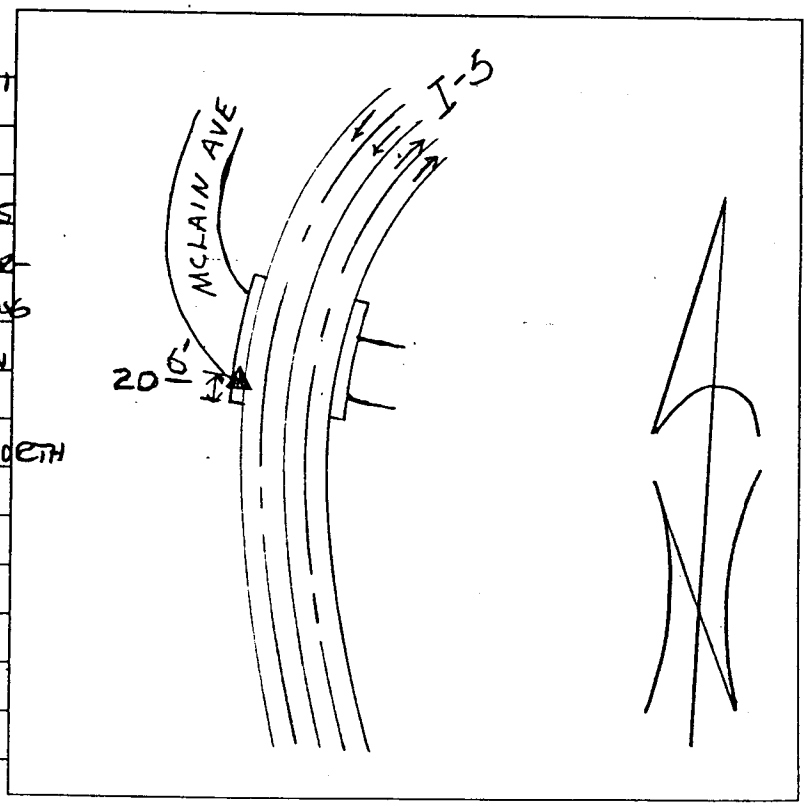
2.26 MI. SOUTH OF ROSEBURG, OR., SET IN S.W. CORNER OF MCLAIN AVE. O'XING (M.P. +/- 121.7) ON TOP OF CONC. BRIDGE "F" RAIL. - FROM EXIT 125 (GARDEN VALLEY BLVD) PROCEED SOUTHERLY ON I-5 3.4 MI. TO MCLAIN AVE. O'XING (EXIT 122 - M.P. 121.7). BRONZE DISK SET IN TOP OF CONC. BRIDGE RAIL (TYPE "F") AT SW CORNER OF O'XING 6.3 MET. NORTH OF THE SOUTH END OF THE BRIDGE RAIL AT SW CORNER OF THE BRIDGE ABUTMENT.