


OFFICE OF THE

DOUGLAS COUNTY SURVEYOR

j-004
J-451

22S 4W 30

NAD 726003.09 4201560.77
83 43°37'36" 123°13' 7"

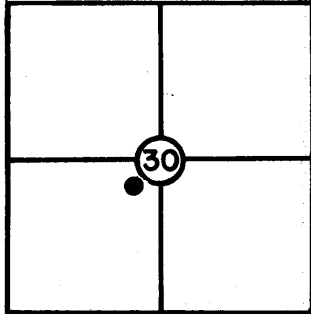

T 22 S, R 4W, Sec. 30

Station: J 451

Set By (Agency): USGS

Date: 1953

VERTICAL CONTROL

NGVD 29

Elevation: 395.000 NGS(USC&GS) Line # _____ OSHD
~~USGS~~ Line # 369 P. 10

Order Of Precision 3rd Agency: OSHD Proj. #: _____ Date: 1956 ADJ.

HORIZONTAL CONTROL

NAD 27

Oregon State Plane Coordinates: Y(Northing) 726,037.70 X(Easting) 1,280,600.28
(South Zone)


Order Of Precision 1/25,000 Agency: DCSO Proj. #: C.S. 60/23 Date: 1978
2010-6

Approximate Geographic Position: Latitude= _____ Longitude= _____

DESCRIPTION: Brass cap stamped "J 451 1953"

is in the sidewalk of the NW corner of the
Elk Cr. Bridge, 26' W. of the NB Centerline.

SKETCH

 

VICINITY: 6.8mi. SE of Anlauf along Pacific
Hwy., approx. 6.5mi. S.of the Anlauf
Grade Separation Structure

NOTE: For Possible Further Information On This Station, Please Contact The Douglas County Surveyors Office, Rm. 205 Douglas County Justice Bldg., Roseburg, OR. 97470 Phone 672-3311 Ext. 272.. Douglas County residents outside the Roseburg calling area dial toll free 1-800-452-0991.