

OFFICE OF THE
DOUGLAS COUNTY SURVEYOR


Station: U-70-A
Set By (Agency): DCSO
Date Set: 1972
Recovered By DCSO
Date Recovered 2-17-82
Recovered By GQ-TP
Date Recovered _____
Recovered By _____
Date Recovered _____

T 22 S, R 9W , Sec 13



U-072 22S 9W 13
U-70-A

NAD 742883.27 4069017.12
83 43°39'36" 123°43'17"

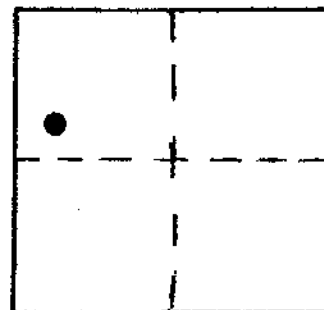

VERTICAL CONTROL

Elevation: _____ NGS Line # _____ USGS Line # _____ OSHD Line # _____
Precision: _____ Agency: _____ Proj. # _____ Date: _____

HORIZONTAL CONTROL


South Zone State Plane Coordinates: Y(Northing) 742,918.08 X(Easting) 1,148,056.78
Precision: 1/25,000 Agency: DCSO Proj. # 2006 Date: 1972
Approximate Geographic Position: Latitude 43°39'37" Longitude 123°43'13"

DESCRIPTION and TO REACH

Found: Standard DCSO disk set in boulder
flush with ground stamped "U-70-A 1972".

To reach: From the intersection of Hwy #38
and Weatherly Cr. Rd. #22-9-14.0 (in sec.14
T22S R9W) proceed Easterly along Hwy. #38
0.90 miles to station on the right.

SKETCH

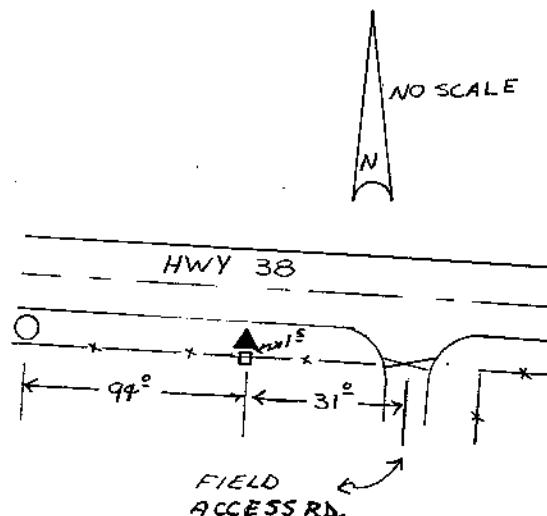

Reference Marks:

Note: For further information, contact the Douglas County Surveyor's Office, Room 205
Douglas County Justice Building, Roseburg, OR 97470. Phone 440-4278. Douglas
County residents outside the Roseburg calling area, dial toll free 1-800-452-0991.