


OFFICE OF THE

DOUGLAS COUNTY SURVEYOR

u-091
U-86

22S 11W 2

NAD 757112.38 3999464.81
83 43°41'29" 123°59'10"

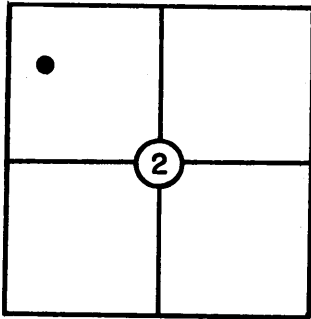

U-091

T 22 S, R 11W, Sec. 2

Station: U-88

Set By (Agency): DCSO

Date: 1973

VERTICAL CONTROL NGVD 29

Elevation: 10.329 NGS(USC&GS) Line # _____ USGS Line # _____

Order
Of Precision 3rd Agency: DCSO Proj. #: 2006 Date: 1973

HORIZONTAL CONTROL NAD 83

Oregon State Plane Coordinates: Y(Northing) 757,147.24 X(Easting) 1,078,503.98
(South Zone)

Order
Of Precision 1/20,000 Agency: DCSO Proj. #: 2006 Date: 1973

Approximate Geographic Position: Latitude= _____ Longitude= _____


DESCRIPTION: The sta. is located E. on Hwy.
#38 approx. 6.0 mi. from the P.O. in Reedsport.

Sta. is just off the left shoulder of the road
7 ft. lower than the road.

Bronze cap stamped "U-88 1973" set in con-
crete in a 6" x 36" belltile.

VICINITY: Hwy. #38 E. of Reedsport.

SKETCH

 

NOTE: For Possible Further Information On This Station, Please Contact The Douglas County Surveyors Office, Rm. 205 Douglas County Justice Bldg., Roseburg, OR. 97470 Phone 672-3311 Ext. 272.. Douglas County residents outside the Roseburg calling area dial toll free 1-800-452-0991.