


OFFICE OF THE
DOUGLAS COUNTY SURVEYOR

S-054
SC-5

22S 12W 2

NAD 758330.57 3973370.73
83 43°41'30" 124° 5' 6"

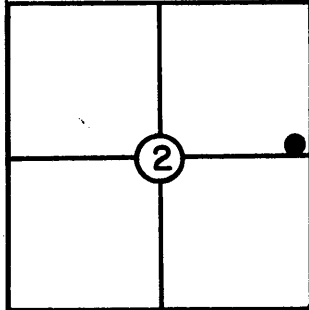

T 22 S, R 12 W, Sec. 2

Station: SC-5

Set By (Agency): DCSO

Date: 1973

S-054

VERTICAL CONTROL NGVD 29

Elevation: 17.292 NGS(USC&GS) Line # _____ USGS Line # _____

Order (River Floodplain)
Of Precision 2nd Agency: DCSO Proj. #: 2006 Date: 1973

HORIZONTAL CONTROL NAD 27


Oregon State Plane Coordinates: Y(Northing) 758,365.71 X(Easting) 1,052,410.01
(South Zone)

Order (River Floodplain)
Of Precision 1/25,000 Agency: DCSO Proj. #: 2006 Date: 1973

Approximate Geographic Position: Latitude= 43° 41' 31" Longitude= 124° 05' 02"

DESCRIPTION: A standard DCSO brass cap set
in a conc. filled 6"x36" bell tile stamped
"SC-5". No date on cap, 18.8 ft N30°E,
from Northerly rail of SPRR, 3 ft. Southerly
of "T" iron fence post.

SKETCH

 

VICINITY: Approx. 6200 ft. along SPRR SE'stly
from intersection of SPRR and Winchester
Ave. in Reedsport.

NOTE: For Possible Further Information On This Station, Please Contact The Douglas County Surveyors Office, Rm. 205 Douglas County Justice Bldg., Roseburg, OR. 97470 Phone 672-3311 Ext. 272.. Douglas County residents outside the Roseburg calling area dial toll free 1-800-452-0991.