



OFFICE OF THE
DOUGLAS COUNTY SURVEYOR

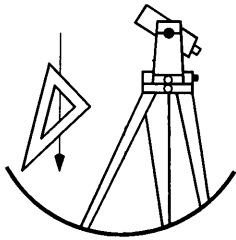

Station: SPER
Date Set: 1969
Set By (Agency): CORPS OF ENGNRS
DCSO Designation: S-120
Date Recovered: _____
Recovered By: _____
Date Recovered: _____
Recovered By: _____
Date Recovered: _____
Recovered By: _____

T22W R13W Sec. 12

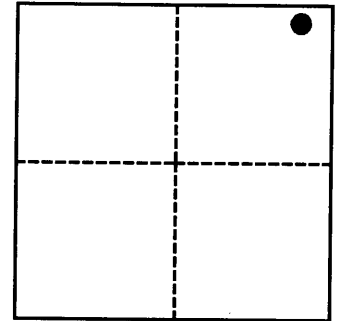

S-120

VERTICAL CONTROL

NGVD 29 Elevation: _____ FEET NAVD 88 Elevation: _____ METERS
NGS Line # _____ USGS LINE # _____ OSHD Line # _____ FILE # _____
Precision: _____ Agency: _____ Proj: _____ Date: _____

HORIZONTAL CONTROL

O.C.S. 27 Y(Northing): 756,165.72 O.C.S. 83 Y(Northing): 756,130.73
(South Zone) X(Easting): 1,025,617.86 (South Zone) X(Easting): 3,946,578.52
Precision: 1/15000 Agency: DCSO Proj: 2008 Date: 1980
Approx. O.C.S. 27 Geographic Position: Latitude: 43°40'57" Longitude: 124°11'04"
Approx. O.C.S. 83 Geographic Position: Latitude: 43°40'57" Longitude: 124°11'09"

Description: A bronze disk set in a 55 gallon drum 2.7 feet in the ground, drum measures 2 foot in diameter.

To reach: Salmon Harbor, north end of most westerly Peninsula

