u-043 23S 7W 21
U-41

OFFICE OF THE

DOUGLAS COUNTY SURVEYOR

| NAD | 701636.07 | 4115024.30 |
|---|---|---|
| 83 | 43°33' 6" | 123°32'31" |

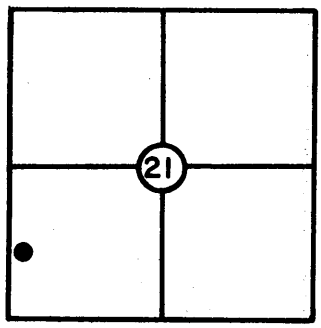


U-043

T 23 S, R 7W, Sec. 21

Station: U-41

Set By (Agency): DCSO

Date: 1972

## VERTICAL CONTROL

NGVD 29

Elevation: 192.741 NGS(USC&GS) Line # _____ USGS Line # _____

Order Of Precision 2nd Agency: DCSO Proj. #: 2006 Date: 1972

## HORIZONTAL CONTROL

NAD 27

Oregon State Plane Coordinates: (South Zone) Y(Northing) 701,670.89 X(Easting) 1,194,064.49

Order Of Precision 1/10,000 Agency: DCSO Proj. #: 2006 Date: 1972

Approximate Geographic Position: Latitude= _____ Longitude= _____

DESCRIPTION: Bronze disk set in concrete post survey marker alongside. South side of road. Sta. is approx. 9 ft. South of road edge.

SKETCH

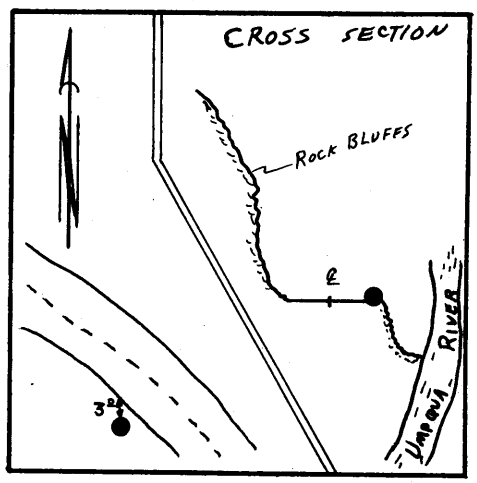


VICINITY: From junction of Hwy. 138 and Maupin Rd. Go E'stly 0.7 mi.

NOTE: For Possible Further Information On This Station, Please Contact The Douglas County Surveyors Office, Rm. 205 Douglas County Justice Bldg., Roseburg, OR. 97470 Phone 672-3311 Ext. 272.. Douglas County residents outside the Roseburg calling area dial toll free 1-800-452-0991.