


OFFICE OF THE
DOUGLAS COUNTY SURVEYOR

U-039
U-37

23S 7W 30

NAD 696714.88 4106049.60
83 43°32'14" 123°34'30"

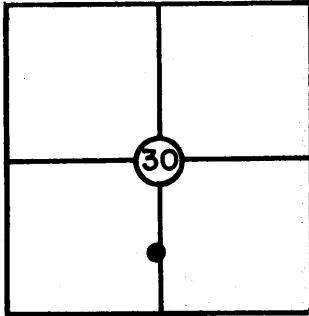

T 23 S, R 7W, Sec. 30

Station: U-37

Set By (Agency): DCSO

Date: 1972

NGVD 29

VERTICAL CONTROL

Elevation: 257.984 NGS(USC&GS) Line # _____ USGS Line # _____

Order
Of Precision 2nd Agency: DCSO Proj. #: 2006 Date: 1972

HORIZONTAL CONTROL

NAD 27

Oregon State Plane Coordinates: Y(Northing) 696,749.63 X(Easting) 1,185,089.87
(South Zone)

Order
Of Precision 1/25,000 Agency: DCSO Proj. #: 2006 Date: 1972

Approximate Geographic Position: Latitude= _____ Longitude= _____

DESCRIPTION: From Hwy. 138 at Kellogg cont.

W. and S. on Bullock Rd. approx. 2.0 mi.


Sta. is bronze cap in concrete belltile.

10 ft W. and 5 ft. above the road edge.

25 ft. from centerline of the road.

VICINITY: Bullock Rd. S. and W. of Kellogg.

SKETCH

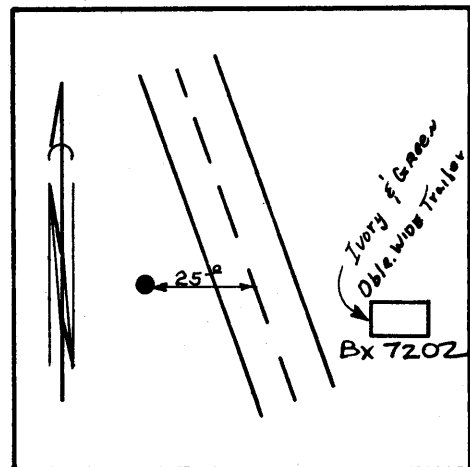

NOTE: For Possible Further Information On This Station, Please Contact The Douglas County Surveyors Office, Rm. 205 Douglas County Justice Bldg., Roseburg, OR. 97470 Phone 672-3311 Ext. 272.. Douglas County residents outside the Roseburg calling area dial toll free 1-800-452-0991.